

ALL LINES UTILITY SERVICES
12211 W FAIRVIEW AVE.
STOP 4
MILWAUKEE, WI 53226
(414) 302-9750

Private Lines Inc.

PRIVATE LINES INC.
E3221 STATE RD. 161
IOLA, WI 54945
(888) 246-0220



Dept. of Veterans Affairs
Medical Center
5000 W. National Avenue
Milwaukee, WI



CONSULTANTS:



Donner Farber Associates
213 Nicollet Mall
Minneapolis, MN 55402
phone 612.332.7322
fax 612.332.0936
www.donnerfarber.com



www.thesigmagroup.com
1300 West Canal Street
Milwaukee, WI 53233
Phone: 414-643-4200
Fax: 414-643-4210

PROJECT LEADER:



ASHLAND, WI
211 6TH STREET WEST
ASHLAND, WI 54806
PHONE: (715) 682-0004
FAX: (715) 682-0003
MILWAUKEE, WI
803 N. MAYFAIR RD.
SUITE 300
MILWAUKEE, WI 53208
PHONE: (414) 258-0004
FAX: (414) 258-0154

Drawing Title
**Work Phasing & Bid
Alternate Descriptions**

Approved: Project Director

Project Title
**SITE SOUTH EAST
AREA PARKING LOT**

Location
VA Medical Center, Milwaukee, WI

Date
December 12, 2013

Checked By:
DJC/MAB

Drawn By:
NLB

100% CONSTRUCTION DOCUMENTS

Project Number
695-13-174



Building Number
-

Drawing Number
C001

Office of
Facilities
Management



Department of
Veterans Affairs

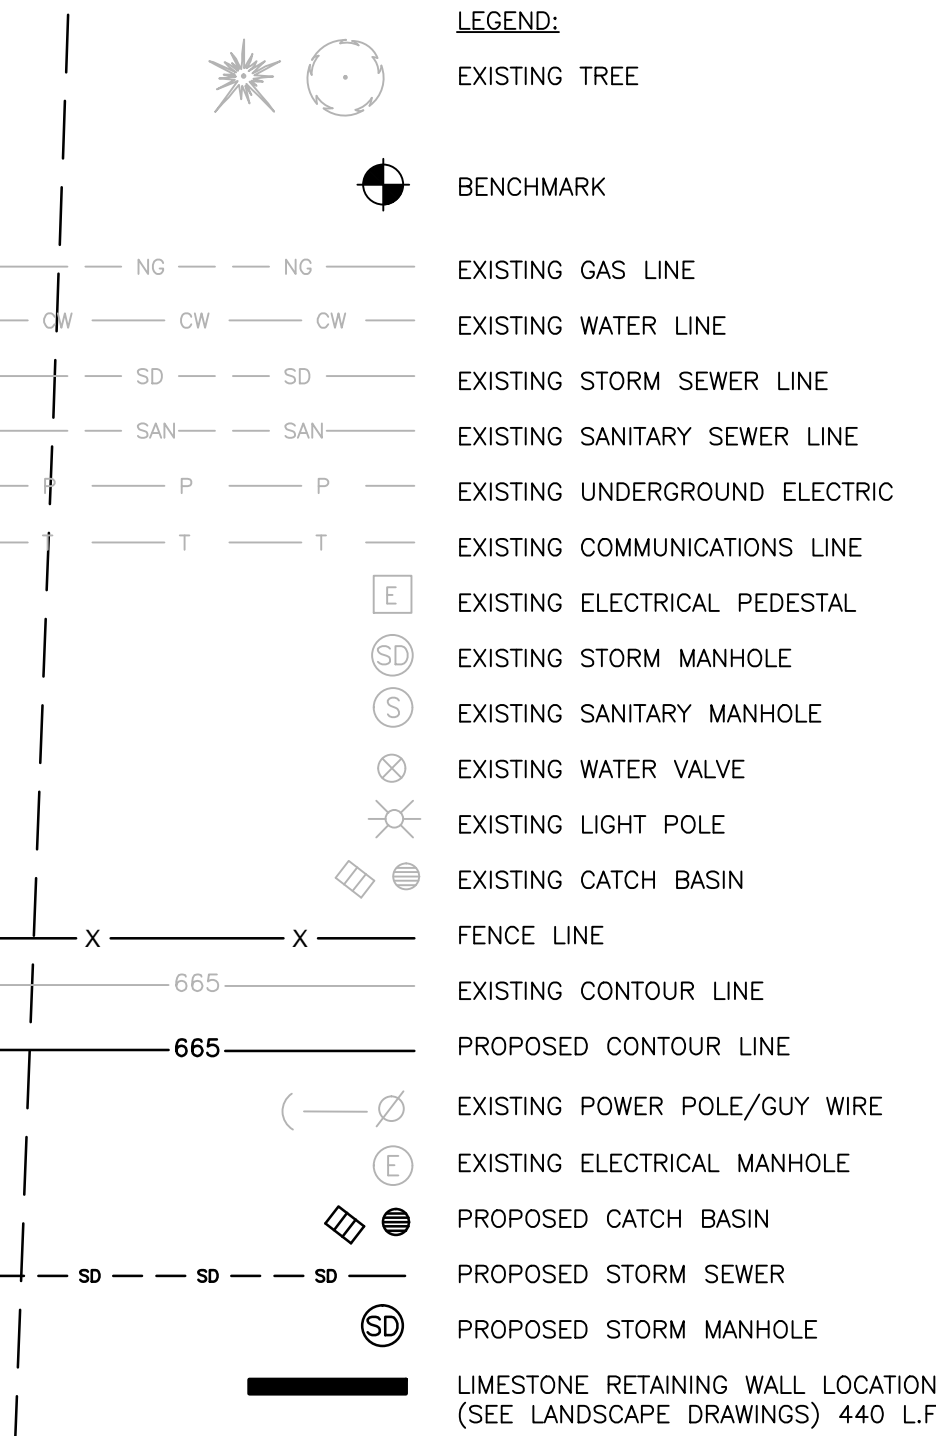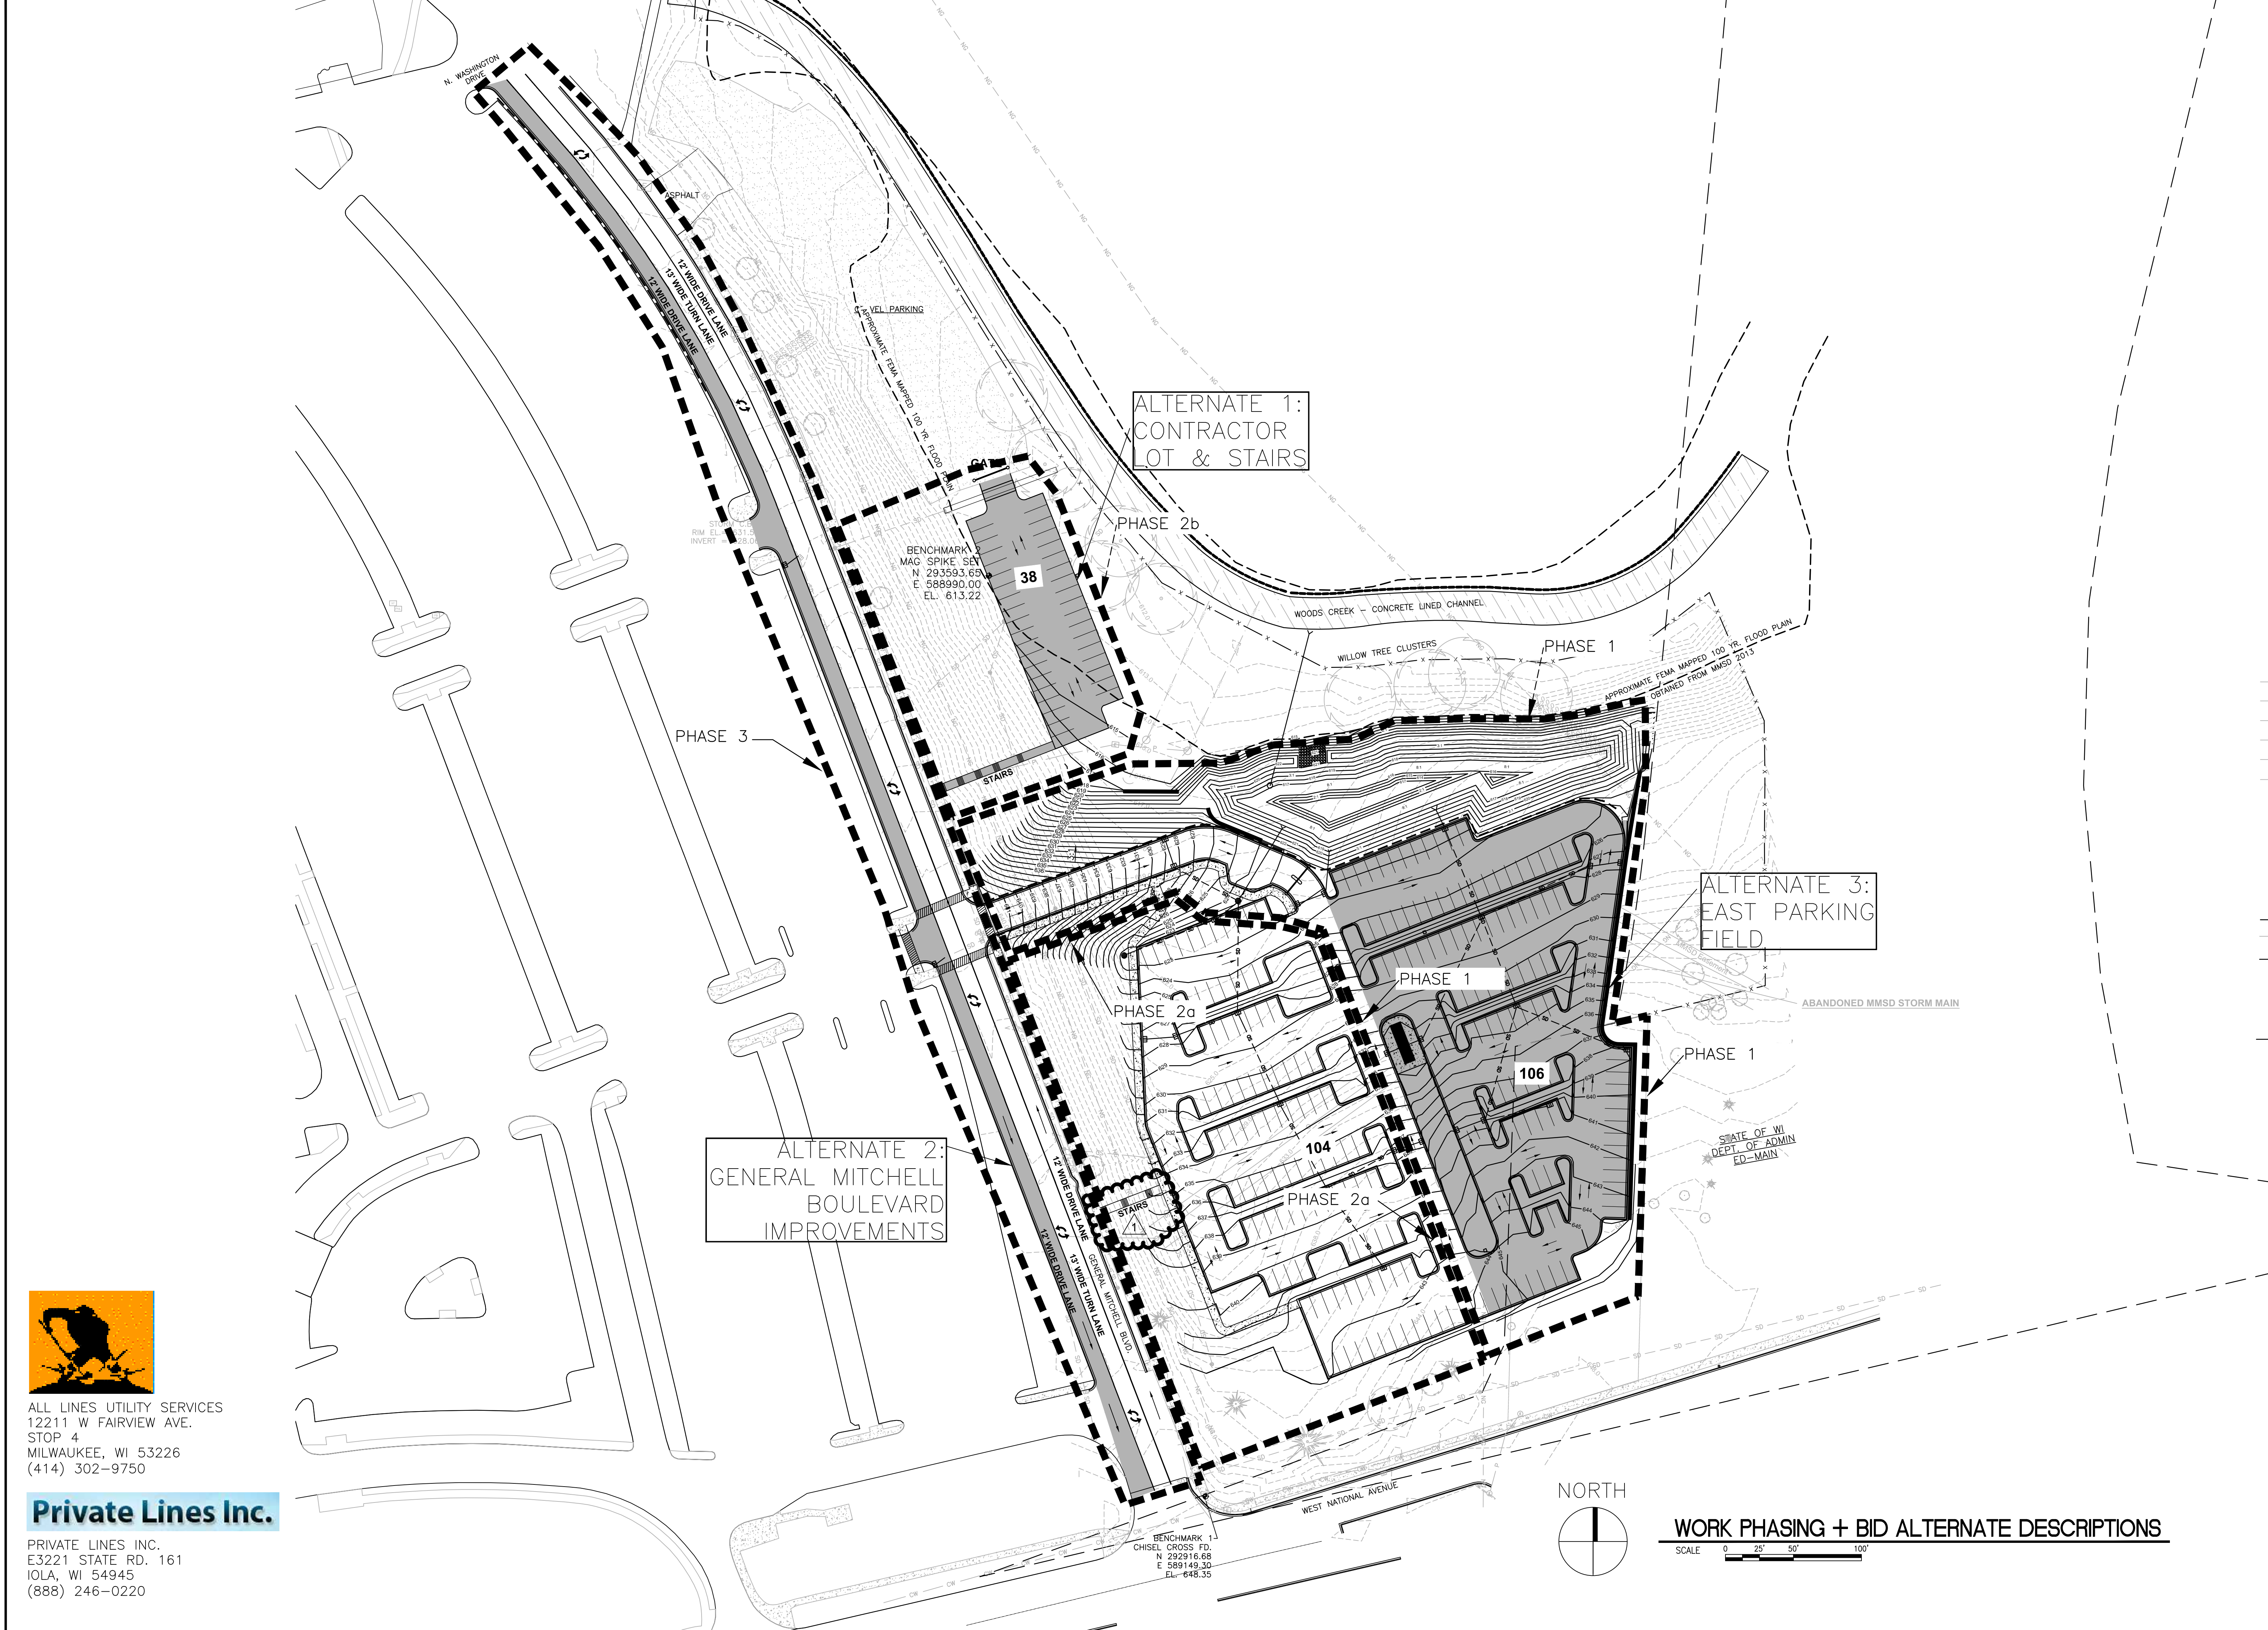

GENERAL NOTE:
SEE SPECIFICATION SECTION 01 00 00-GENERAL REQUIREMENTS FOR DETAILED BID ALTERNATE LANGUAGE. CONTACT VA COR WITH QUESTIONS RELATED TO EACH ALTERNATE AND ASSOCIATED WORK.
PHASE 3 WORK 1700 HRS TO 0400 HRS (NIGHTS ONLY)

NOTES:

TEMPORARY CONTROLS TO BE REMOVED AT PROJECT STABILIZATION

- SILT FENCE/STRAW BALES
- TEMPORARY INLET PROTECTION
- RIPRAP TRACKING PAD

RIPRAP AT OUTFALLS TO BE PERMANENT AS WELL AS EROSION MATTING, SEEDING AND VEGETATIVE METHOD'S SHOWN.

SEED MIXES TO BE REFERENCED FROM LANDSCAPE PLAN (SHEET L100)

CONTRACTOR SHALL EMPLOY EROSION CONTROL METHODS AS SHOWN AND SPECIFIED IN WISCONSIN DEPARTMENT OF NATURAL RESOURCES CONSTRUCTION SITE TECHNICAL STANDARDS AND WISDOT EROSION CONTROL PRODUCT ACCEPTABILITY LISTS (PAL).

EROSION CONTROL MEASURES SHALL BE ADJUSTED TO MEET FIELD CONDITIONS AT TIME OF CONSTRUCTION AND SHALL BE INSTALLED PRIOR TO ANY GRADING OR DISTURBANCE OF EXISTING SURFACE MATERIAL ON SITE.

EROSION AND SEDIMENT CONTROL MEASURES SHALL BE CHECKED FOR STABILITY AND OPERATION AFTER A RAINFALL OF 0.5 INCHES OR MORE BUT NO LESS THAN ONCE EVERY WEEK. ANY NEEDED REPAIRS WILL BE MADE IMMEDIATELY. WRITTEN REPORTS, EROSION AND SEDIMENT CONTROL INSPECTIONS ARE AS REQUIRED BY WISCONSIN DEPARTMENT OF NATURAL RESOURCES (WDNR).

SILT FENCE SHALL BE INSTALLED IN LOCATIONS SHOWN ON CONSTRUCTION PLANS. SILT FENCE SHALL BE INSTALLED PER DETAILS ON SHEET C300. SEDIMENT DEPOSITS: REMOVE FROM BEHIND SILT FENCE WHEN DEPOSITS REACH DEPTH OF 6 INCHES. SILT FENCE: REPAIR OR REPLACE TO MAINTAIN BARRIER.

EROSION CONTROL MEASURES SHALL BE MAINTAINED ON CONTINUING BASIS UNTIL SITE IS PERMANENTLY STABILIZED. SITE STABILIZATION INVOLVING SEEDING WHICH IS NOT COMPLETED PRIOR TO SEPTEMBER 15 SHALL BE COMPLETED WITH DORMANT SEEDING BY NOVEMBER 1. SODDING MAY OCCUR ANYTIME SOD IS AVAILABLE AND SOD AND SOIL IS NOT FROZEN.

INLET GRATE SCREENS SHALL BE INSTALLED ON EXISTING AND PROPOSED INLETS AND CATCH BASINS. REFERENCE SITE UTILITY DRAWINGS FOR LOCATION OF PROPOSED INLETS AND CATCH BASINS. FOR STRUCTURES IN DISTURBED AREAS THAT WILL NOT BE FINISHED AND VEGETATION ESTABLISHED WITHIN 30 DAYS, CURB INLET SEDIMENT BARRIERS SHALL BE USED IN LIEU OF INLET GRATE SCREENS. INLET PROTECTION SHALL BE PER PLAN AND DETAILS ON SHEET C301.

EROSION CONTROL MEASURES MUST BE IN PLACE AT END OF EACH WORKDAY.

SEDIMENT DEPOSIT/TRACKING FROM CONSTRUCTION WORK OR STORM EVENTS: CLEAN UP BY END OF EACH DAY. FLUSHING NOT ALLOWED

WHERE CONSTRUCTION ACTIVITIES HAVE PERMANENTLY CEASED OR HAVE TEMPORARILY BEEN SUSPENDED FOR MORE THAN FOURTEEN DAYS, OR WHEN FINAL GRADES ARE REACHED IN ANY PORTION OF SITE, STABILIZATION SHALL BE IMPLEMENTED WITHIN SEVEN DAYS. TEMPORARY STABILIZATION PRACTICES SUCH AS MULCH/TACKIFIER, EROSION MAT, OR WISDOT TYPE B SOIL STABILIZER (POLYMER) SHALL BE APPLIED TO SOIL SURFACE WHEN SITE IS NOT READY FOR PERMANENT RESTORATION. WHEN STABILIZATION NOT POSSIBLE DUE TO SNOW COVER, STABILIZATION MEASURES SHALL BE INITIATED AS SOON AS POSSIBLE.

DUST CONTROL SHALL BE IMPLEMENTED THROUGHOUT CONSTRUCTION AND SHALL UTILIZE METHODS OUTLINED IN WDNR TECH STD. 1068. AT MINIMUM, WATER SPRAY OPEN SOIL AND TRACKING ONCE EACH WORK DAY.

REMOVAL OF VEGETATIVE COVER AND EXPOSURE OF BARE GROUND MUST BE RESTRICTED TO MINIMUM AMOUNT NECESSARY FOR CONSTRUCTION. AREAS WHERE SOIL IS EXPOSED MUST BE PROTECTED FROM EROSION BY SEEDING AND MULCHING, SODDING, DIVERSION OF SURFACE RUNOFF, INSTALLATION OF STRAW BALES OR SILT SCREENS, CONSTRUCTION OF SETTLING BASINS, OR SIMILAR METHODS AS SOON AS POSSIBLE AFTER REMOVAL OF ORIGINAL GROUND COVER AS DESCRIBED IN WISCONSIN DNR TECHNICAL STANDARDS. ANY STOCKPILE THAT REMAINS OVER 7 DAYS MUST BE STABILIZED WITH MIXTURE NO. 20 FROM WISDOT SECTION 630.


STORM WATER AND GROUND WATER PUMPED FROM EXCAVATIONS AND/OR DEWATERING WELLS SHALL BE DISPOSED OF IN ACCORDANCE WITH WISCONSIN STATUTES. SEDIMENT BASINS, SEDIMENT TRAPS AND/OR USE OF POLYMERS TO CONTROL SEDIMENT: NOT ALLOWED. DISCHARGE OR PUMPED WATER TO SANITARY SEWERS: NOT ALLOWED.

EROSION MAT SHALL CONSIST ENTIRELY OF BIODEGRADABLE COMPONENTS. EVERY SQUARE INCH SHALL BE SECURED TO GROUND: NO BUCKLING, NO GAPS.

AFTER SITE IS UNIFORMLY STABILIZED ACROSS 80% OF SITE AREA, OR PRIOR TO, AT DIRECTION OF DEPARTMENT OF NATURAL RESOURCES, REMOVE TEMPORARY EROSION CONTROL MEASURES AND DISPOSE OF PROPERLY. ANY REMAINING TEMPORARY EROSION CONTROL DEVICES AFTER THIS POINT CONSTITUTE LITTERING AND MAY BE ENFORCED AS DETERMINED NECESSARY BY DEPARTMENT OF NATURAL RESOURCES.

CONTRACTOR SHALL MAINTAIN LOG OF EROSION CONTROL INSPECTIONS, REPAIRS MADE, AND RAIN EVENTS. SUBMIT WITH PAY REQUESTS.

PLACE MINIMUM OF 6 INCHES OF TOPSOIL IN AREAS TO RECEIVE PERMANENT SEEDING. MILL GRIND, AND SCREEN SOD AND TOPSOIL REUSED FROM SITE CLEARING AND GRUBBING. OFF-SITE TOPSOIL: TEST (PHYSICAL AND CHEMICAL) AND PROVE MEETS SPECIFICATIONS, PER EACH SOURCE, AND SUBMIT SAMPLES BEFORE DELIVERY, NUMBER AND TYPE SPECIFIED.

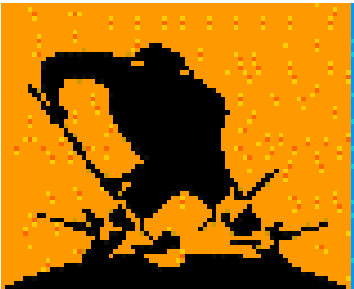


ALL LINES UTILITY SERVICES
12211 W FAIRVIEW AVE.
STOP 4
MILWAUKEE, WI 53226
(414) 302-9750

Private Lines Inc.

PRIVATE LINES INC.
E3221 STATE RD. 161
IOLA, WI 54945
(888) 246-0220

Amendment 1
Revisions: 04/17/14
Date

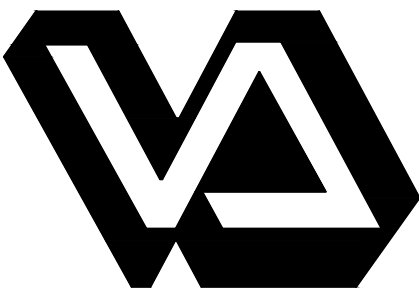

Dept. of Veterans Affairs
Medical Center
5000 W. National Avenue
Milwaukee, WI



CONSULTANTS:



PROJECT LEADER:



ASHLAND, WI
211 6TH STREET WEST
ASHLAND, WI 54806
PHONE: (715) 682-0004
FAX: (715) 682-0003
MILWAUKEE, WI
903 N. MAYFAIR RD.
SUITE 300
MILWAUKEE, WI 53208
PHONE: (414) 258-0004
FAX: (414) 258-0154

Drawing Title

Erosion Control
Plan

Approved: Project Director

Project Title

SITE SOUTH EAST
AREA PARKING LOT

Location

VA Medical Center, Milwaukee, WI

Date
December 12, 2013

Checked By:
DJC/MAB

Drawn By:
NLB

100% CONSTRUCTION DOCUMENTS

Project Number
695-13-174

Building Number
-

Drawing Number


C101

Office of
Facilities
Management




Department of
Veterans Affairs


EROSION CONTROL LEGEND:

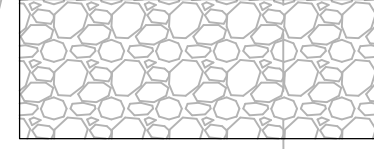


TRACKING PAD - 48 CY, SEE SHEET C301

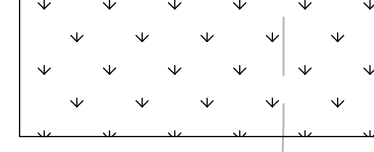


SEEDING OVER EROSION MAT, CLASS I TYPE B
20,980 SQ/FT

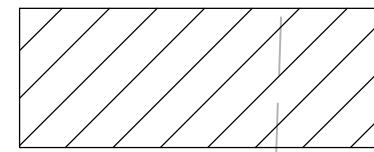


SEEDING OVER EROSION MAT, CLASS II TYPE C
5,704 SQ/FT

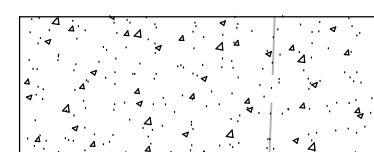

SEEDING OVER EROSION MAT, CLASS II TYPE A (2:1 OR FLATTER)
19,753 SQ/FT

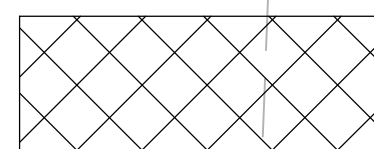

SEEDING OVER EROSION MAT, CLASS I TYPE A (2.5:1 OR
FLATTER) 21,400 SQ/FT

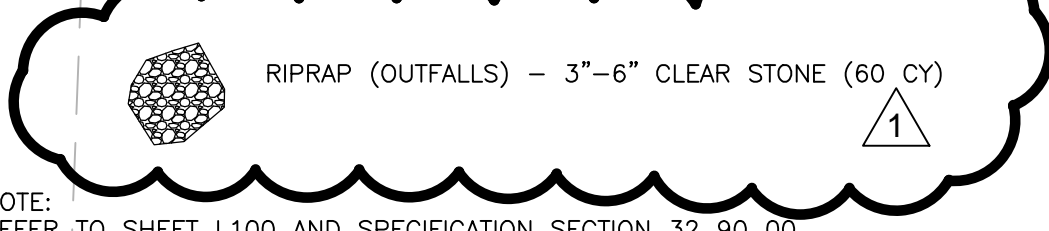

RIPRAP (OUTFALLS) - 3"-6" CLEAR STONE (60 CY)

NOTE: REFER TO SHEET L100 AND SPECIFICATION SECTION 32 90 00 FOR DETAILED PLANTING PLAN

LEGEND:



EXISTING TREE



BENCHMARK



EXISTING GAS LINE



EXISTING WATER LINE



EXISTING STORM SEWER LINE



EXISTING SANITARY SEWER LINE



EXISTING UNDERGROUND ELECTRIC



EXISTING COMMUNICATIONS LINE



EXISTING ELECTRICAL PEDESTAL



EXISTING STORM MANHOLE



EXISTING SANITARY MANHOLE




EXISTING WATER VALVE



EXISTING LIGHT POLE



EXISTING CATCH BASIN

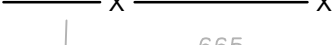

EXISTING CHAIN LINK FENCE LINE



EXISTING CONTOUR LINE



PROPOSED CONTOUR LINE



EXISTING POWER POLE/GUY WIRE



EXISTING ELECTRICAL MANHOLE



COMBINATION SILT FENCE WITH STRAW BALE
REINFORCEMENT - (SEE SHEET C301)
650 L.F.



PROPOSED CATCH BASIN



PROPOSED STORM SEWER



RETAINING WALL LOCATION
(SEE C200)



TYPE D INLET PROTECTION
(4 REQ'D)

NOTES:

MAINTAIN CONDITION OF EXISTING TREES/SHRUBS/VEGETATION AND SOD DURING CONSTRUCTION, TO REMAIN AS PART OF THIS CONTRACT. REPAIR ANY DAMAGE AT NO COST TO GOVERNMENT.

RESTORE, SEED & MULCH GRASSSED AREAS DISTURBED AS PART OF WORK ASSOCIATED WITH THIS CONTRACT.

INLET PROTECTION

NEW INLETS IN CURB LINE TO BE PROTECTED WITH TYPE "C" INLET PROTECTION PRIOR TO SITE STABILIZATION. SEE SHEET C300 FOR DETAILS. (24 NEW INLETS REQUIRE PROTECTION DURING CONSTRUCTION)


NEW ROUND CATCH BASINS IN GRASSSED AREAS TO BE PROTECTED WITH WISDOT TYPE "B" INLET PROTECTION PRIOR TO SITE STABILIZATION. (2 NEW INLETS REQUIRE PROTECTION DURING CONSTRUCTION)

EXISTING CATCH BASINS TO BE PROTECTED WITH WISDOT TYPE "B" INLET PROTECTION DURING CONSTRUCTION ACTIVITIES.

GENERAL CONTRACTOR RESPONSIBLE FOR REMOVING INLET PROTECTION FROM INLETS IDENTIFIED ON THIS PLAN AND IN NOTES ABOVE (FOR PLAN CLARITY) FOLLOWING SITE STABILIZATION OR PAVING COMPLETION.


EROSION CONTROL

INSTALL EROSION CONTROL IN PHASE AREAS BEFORE PHASE OF WORK BEGINS. CONTRACTOR LAYDOWN AREA SHALL BE IN PHASE 2A AREA UNTIL PHASE 1 COMPLETE, THEN MOVE TO PHASE 1 AREA FOR REMAINDER OF WORK.

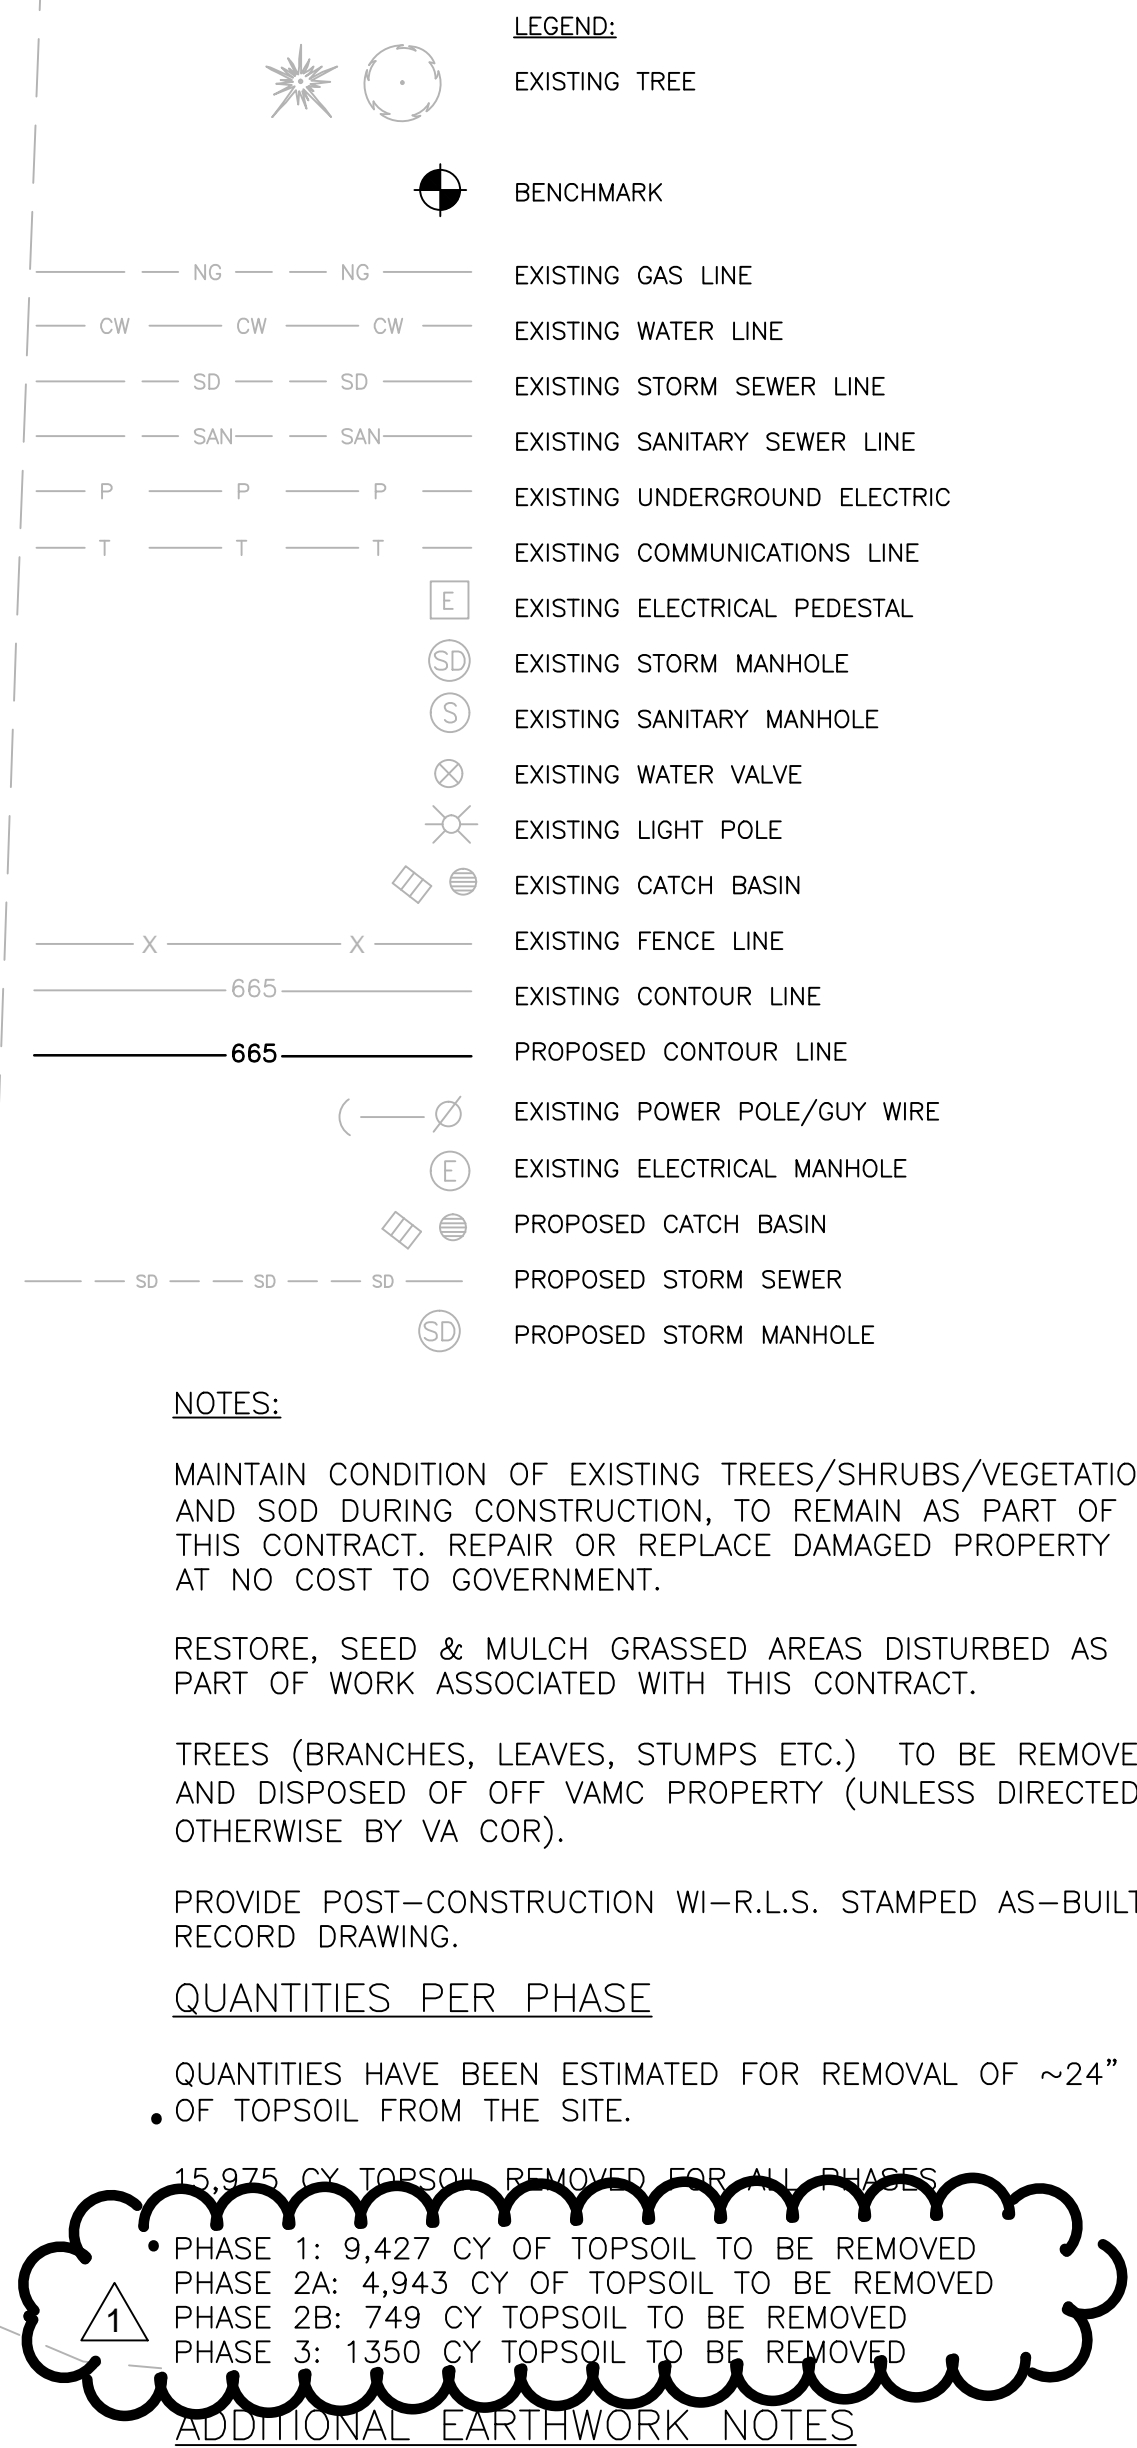

PRIVATE LINES INC.
E3221 STATE RD. 161
IOLA, WI 54945
(888) 246-0220

VA FORM 08-6231, OCT 1978
2014 8:52 AM

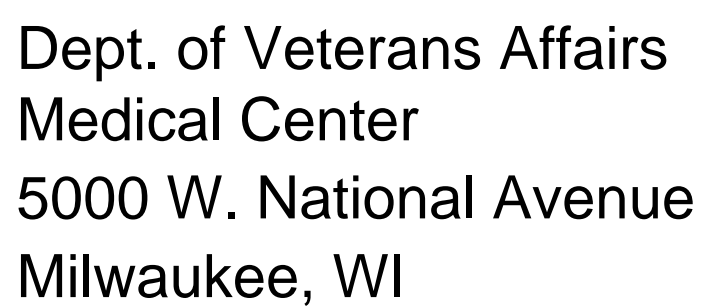

Damon Farber Associates
923 Nicollet Mall
Minneapolis, MN 55402
phone 612.332.7522
fax 612.332.0936
www.damonfarber.com

THE SIGMA GROUP
Single Source. Sound Solutions.

www.thesigmagroup.com
1300 West Canal Street
Milwaukee, WI 53233
Phone: 414-643-4200
Fax: 414-643-4210



ASHLAND, WI
211 6TH STREET WEST
ASHLAND, WI 54806
PHONE: (715) 682-6004
FAX: (715) 682-6025

MILWAUKEE, WI
923 N. MAYFAIR RD.,
SUITE 320
MILWAUKEE, WI 53228
PHONE: (414) 258-6004
FAX: (414) 258-6154

Approved: Project Director

Location	VA Medical Center, Milwaukee, WI
----------	----------------------------------

Date	December 12, 2013
------	-------------------

Checked By:
DJC/MAB

Drawn By:
NLB

C201

 Department of
Veterans Affairs

three inches = one foot

one and one half inches = one foot

one inch = one foot


three quarters inch = one foot

one half inch = one foot

three eighths inch = one foot

one quarter inch = one foot


one eighth inch = one foot

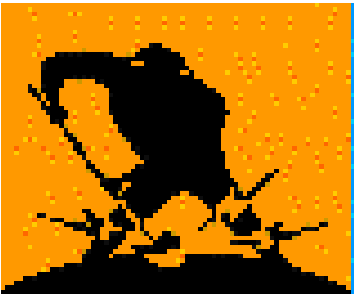

ALL LINES UTILITY SERVICES
12211 W FAIRVIEW AVE.
STOP 4
MILWAUKEE, WI 53226
(414) 302-9750

Private Lines Inc.

PRIVATE LINES INC.
E3221 STATE RD. 161
IOLA, WI 54945
(888) 246-0220

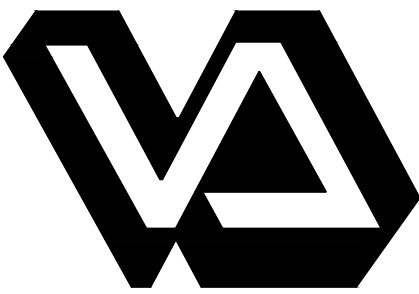

Dept. of Veterans Affairs
Medical Center
5000 W. National Avenue
Milwaukee, WI



CONSULTANTS:



PROJECT LEADER:



ASHLAND, WI
211 6TH STREET WEST
ASHLAND, WI 54806
PHONE: (715) 682-0004
FAX: (715) 682-0003
MILWAUKEE, WI
903 N. MAYFAIR RD.
SUITE 300
MILWAUKEE, WI 53208
PHONE: (414) 258-0054
FAX: (414) 258-0154

Drawing Title
Finished Grading Plan

Approved: Project Director

Project Title
SITE SOUTH EAST AREA PARKING LOT

Location
VA Medical Center, Milwaukee, WI

Date
December 12, 2013

Checked By:
DJC/MAB

Drawn By:
NLB

100% CONSTRUCTION DOCUMENTS

Project Number
695-13-174

Building Number
-

Drawing Number
C202

Office of
Facilities
Management



- LEGEND:**
- EXISTING TREE
 - BENCHMARK
 - EXISTING GAS LINE
 - EXISTING WATER LINE
 - EXISTING STORM SEWER LINE
 - EXISTING SANITARY SEWER LINE
 - EXISTING UNDERGROUND ELECTRIC
 - EXISTING COMMUNICATIONS LINE
 - EXISTING ELECTRICAL PEDESTAL
 - EXISTING STORM MANHOLE
 - EXISTING SANITARY MANHOLE
 - EXISTING WATER VALVE
 - EXISTING LIGHT POLE
 - EXISTING CATCH BASIN
 - EXISTING CONTOUR LINE
 - PROPOSED CONTOUR LINE
 - EXISTING POWER POLE/GUY WIRE
 - EXISTING ELECTRICAL MANHOLE
 - PROPOSED CATCH BASIN
 - PROPOSED STORM SEWER
 - PROPOSED STORM MANHOLE
 - RETAINING WALL LOCATION (SEE C200) 660 SQ/FT

NOTES:

MAINTAIN CONDITION OF EXISTING TREES/SHRUBS/VEGETATION AND SOD DURING CONSTRUCTION, TO REMAIN AS PART OF THIS CONTRACT. REPAIR OR REPLACE DAMAGE AT NO COST TO GOVERNMENT.

RESTORE, SEED & MULCH GRASSED AREAS DISTURBED AS PART OF WORK ASSOCIATED WITH THIS CONTRACT.

TREES (BRANCHES, LEAVES, STUMPS ETC.) TO BE REMOVED AND DISPOSED OF OFF VAMC PROPERTY (UNLESS DIRECTED OTHERWISE BY VA COR).

PROVIDE POST-CONSTRUCTION WI-R.L.S. STAMPED AS-BUILT RECORD DRAWING.

① MAXIMUM LONGITUDINAL SLOPE ON SIDEWALKS TO BE 10%

APPROXIMATE QUANTITIES - BASE BID (ALL THREE PHASES)

14,450 SQYD OF 4" ASPHALT PAVEMENT

3,853 CY BASE AGGREGATE (1-1/4")

6300 L.F. CURB & GUTTER - STRAIGHT

972 L.F. CURB & GUTTER - RADIUS

APPROXIMATE QUANTITIES - PHASE 1

5,702 SQYD OF 4" ASPHALT PAVEMENT

1,267 CY BASE AGGREGATE (1-1/4")

2665 L.F. CURB & GUTTER - STRAIGHT

487 L.F. CURB & GUTTER - RADIUS

APPROXIMATE QUANTITIES - PHASE 2A

4090 SQYD OF 4" ASPHALT PAVEMENT

909 CY BASE AGGREGATE (1-1/4")

1933 L.F. CURB & GUTTER - STRAIGHT

165 L.F. CURB & GUTTER - RADIUS

APPROXIMATE QUANTITIES - PHASE 2B

1,192 SQYD OF 4" ASPHALT PAVEMENT

265 CY BASE AGGREGATE (1-1/4")

APPROXIMATE QUANTITIES - PHASE 3

3,466 SQYD OF 4" ASPHALT PAVEMENT

1,412 CY BASE AGGREGATE (1-1/4")

1702 L.F. CURB & GUTTER - STRAIGHT

320 L.F. CURB & GUTTER - RADIUS

ADDITIONAL EARTHWORK NOTES


CONTRACTOR TO COMPLETE EARTHWORK WITHIN PROPOSED PARKING LOT IN TWO DISTINCT PHASES. EACH PHASE WILL UTILIZE THE OTHER AS A LAYDOWN / STORAGE AREA.

GENERAL CONTRACTOR WILL BE RESPONSIBLE FOR SUBMITTING PHASING PLAN TO VA COR FOR APPROVAL AND WILL BE REQUIRED TO USE INTERNAL AREAS FOR LAYDOWN AND STORAGE.

ONCE CONSTRUCTION IS COMPLETE, PRESSURE WASH PAVEMENT TO PURE BLACK ASPHALT WITH NO DIRT AND DEBRIS - SUBJECT TO APPROVAL FROM VA COR.


MOBILIZATION:

EARTHWORK, CONCRETE AND PAVING CONTRACTORS SHALL MOBILIZE THREE (3) TIMES, ONCE PER PHASE.

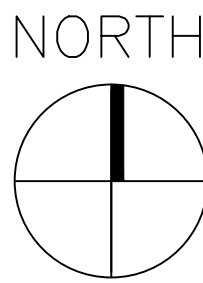

FINISHED GRADING PLAN (PHASES NOT SHOWN)

SCALE 0 25' 50' 100'

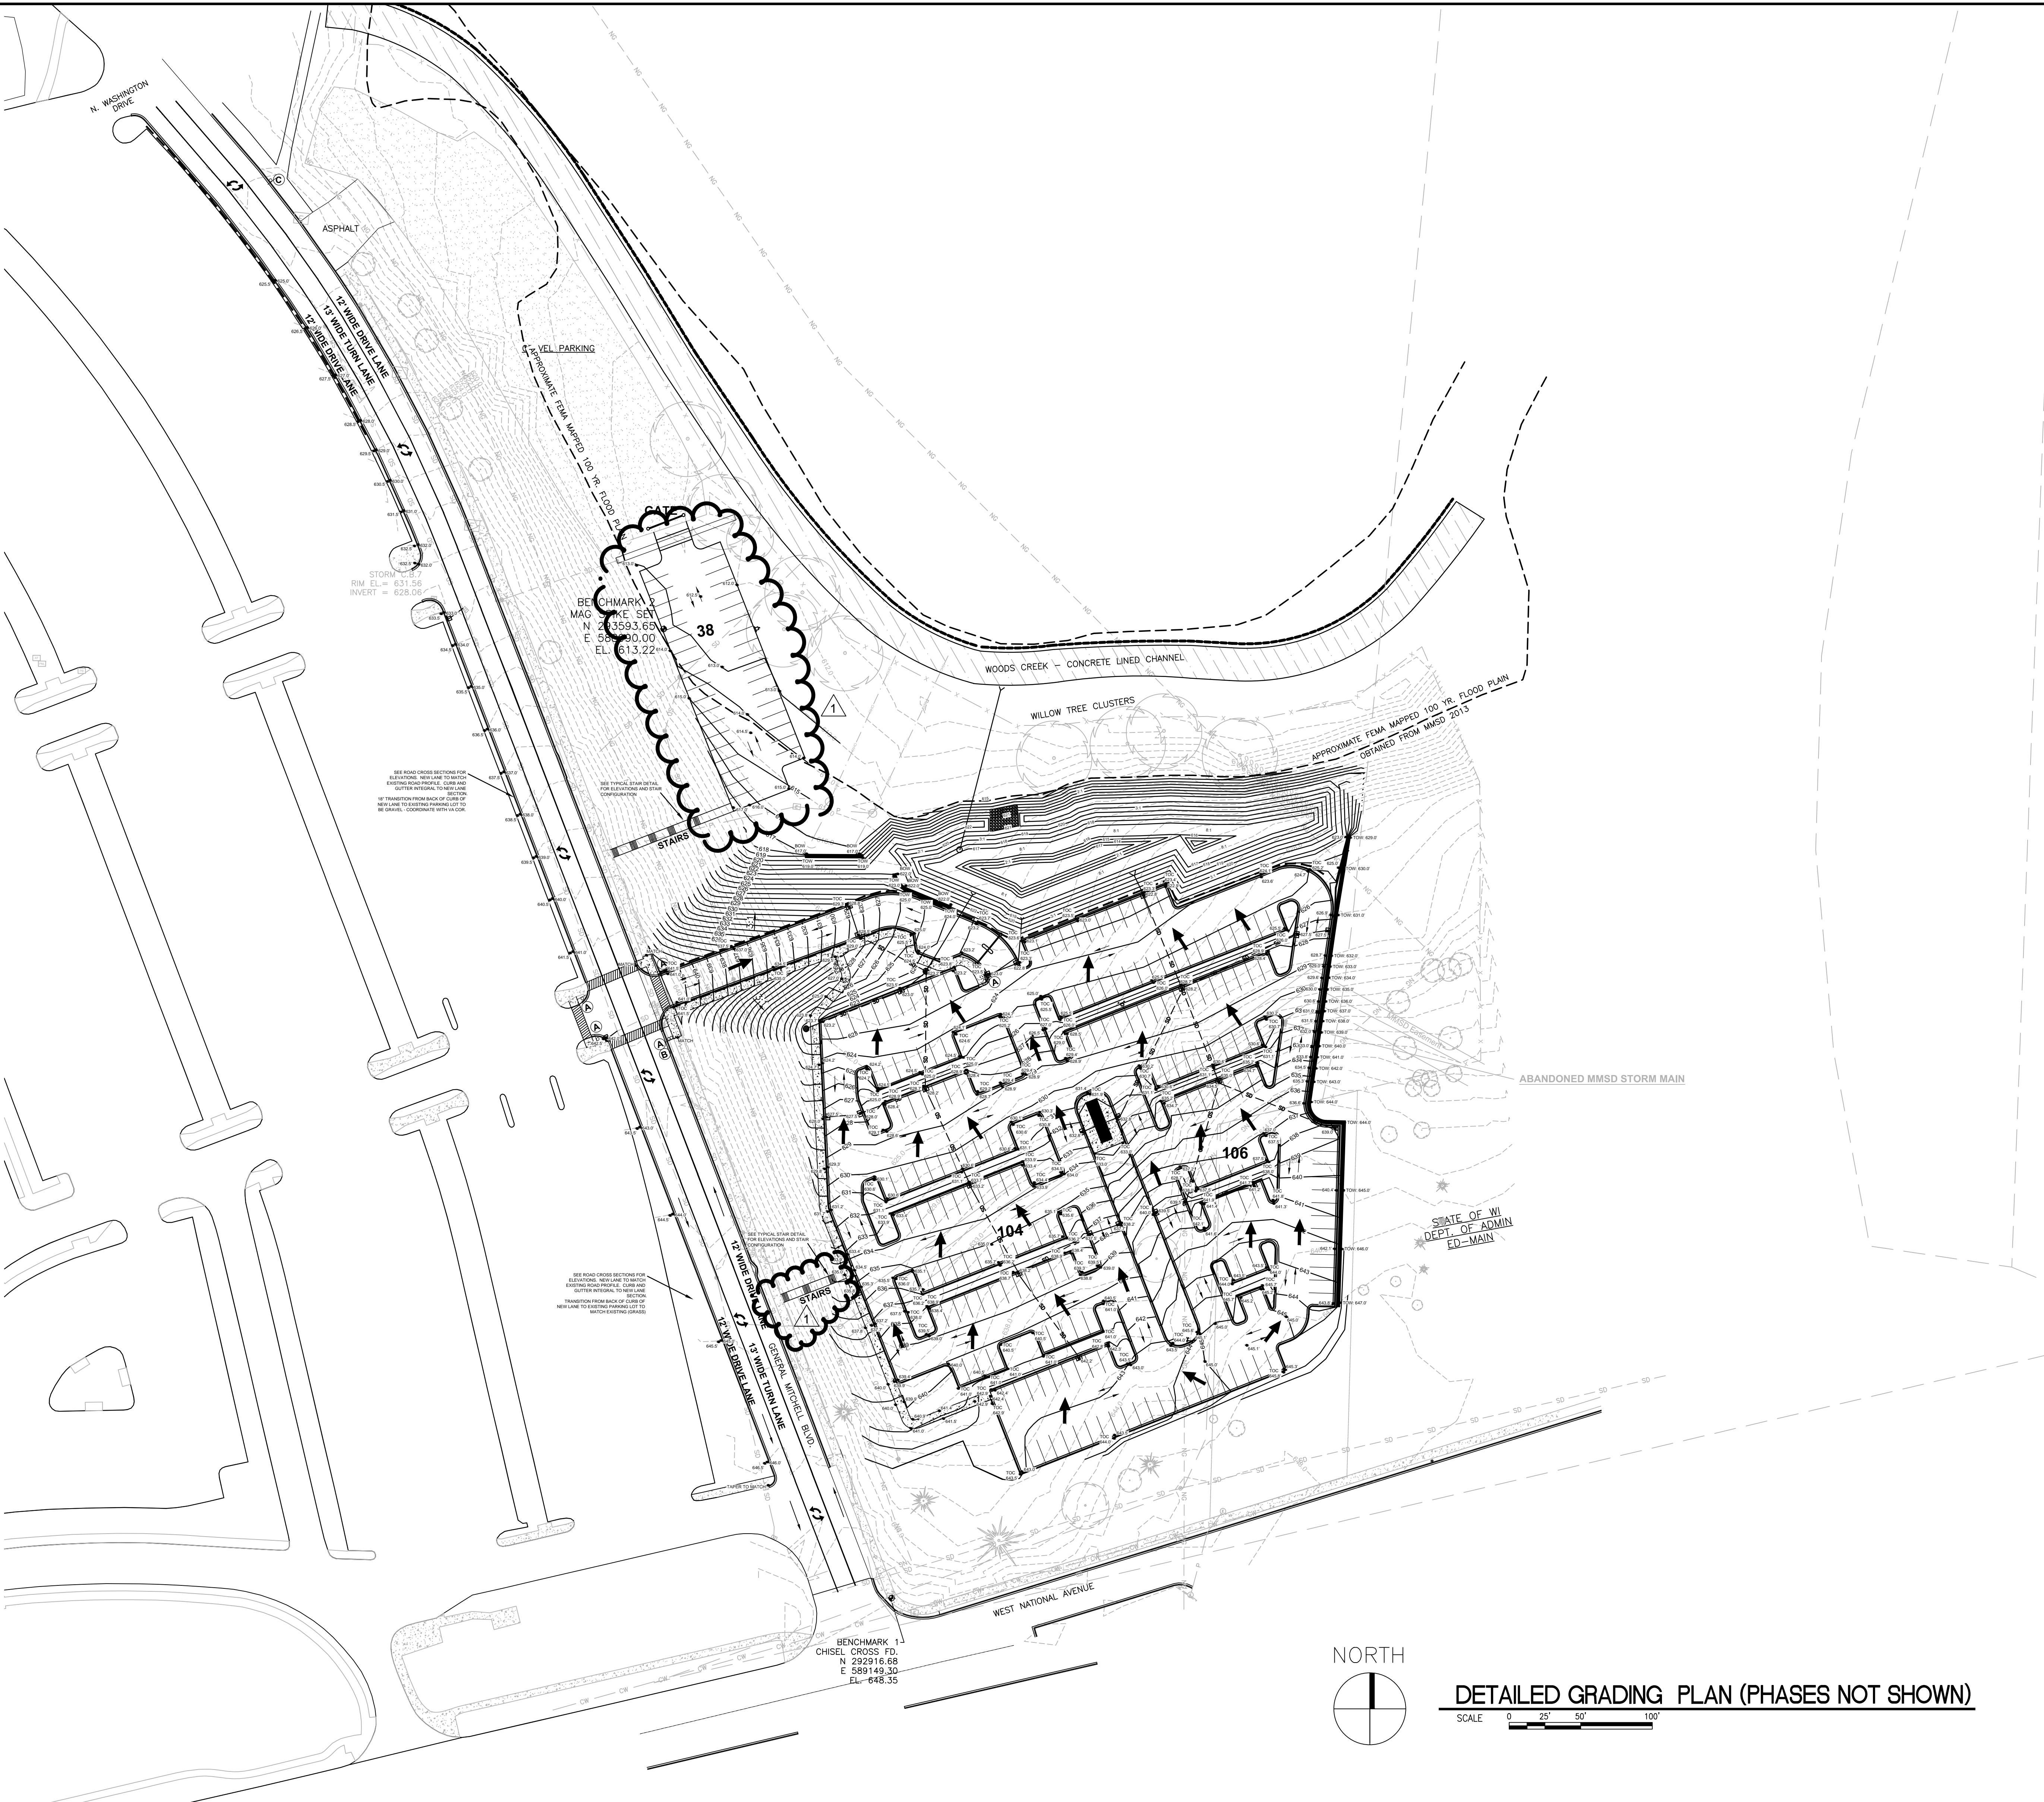

- LEGEND:**
- EXISTING TREE
 - BENCHMARK
 - EXISTING GAS LINE
 - EXISTING WATER LINE
 - EXISTING STORM SEWER LINE
 - EXISTING SANITARY SEWER LINE
 - EXISTING UNDERGROUND ELECTRIC
 - EXISTING COMMUNICATIONS LINE
 - EXISTING ELECTRICAL PEDESTAL
 - EXISTING STORM MANHOLE
 - EXISTING SANITARY MANHOLE
 - EXISTING WATER VALVE
 - EXISTING LIGHT POLE
 - EXISTING CATCH BASIN
 - EXISTING CONTOUR LINE
 - PROPOSED CONTOUR LINE
 - EXISTING POWER POLE/GUY WIRE
 - EXISTING ELECTRICAL MANHOLE
 - PROPOSED CATCH BASIN
 - PROPOSED STORM SEWER
 - PROPOSED STORM MANHOLE
 - RETAINING WALL LOCATION (SEE LANDSCAPE DRAWINGS)
 - FINISHED SPOT ELEVATION
 - TOP OF CURB ELEVATION
 - TOP OF WALL ELEVATION
 - FLOW ARROW

NOTES:

MAINTAIN CONDITION OF EXISTING TREES/SHRUBS/VEGETATION AND SOD DURING CONSTRUCTION, TO REMAIN AS PART OF THIS CONTRACT. REPAIR OR REPLACE DAMAGE AT NO COST TO GOVERNMENT.

RESTORE, SEED & MULCH GRASSED AREAS DISTURBED AS PART OF WORK ASSOCIATED WITH THIS CONTRACT.

TREES (BRANCHES, LEAVES, STUMPS ETC.) TO BE REMOVED AND DISPOSED OF OFF VAMC PROPERTY (UNLESS DIRECTED OTHERWISE BY VA COR).

PROVIDE POST-CONSTRUCTION WI-R.L.S. STAMPED AS-BUILT RECORD DRAWING.

① MAXIMUM LONGITUDINAL SLOPE ON SIDEWALKS TO BE 10%

APPROXIMATE QUANTITIES - BASE BID (ALL THREE PHASES)

- 14,450 SQ/YD OF 4" ASPHALT PAVEMENT
- 3,853 CY BASE AGGREGATE (1-1/4")
- 6300 L.F. CURB & GUTTER - STRAIT
- 635 L.F. CURB & GUTTER - RADIUS

ADDITIONAL EARTHWORK NOTES


CONTRACTOR TO COMPLETE EARTHWORK WITHIN PROPOSED PARKING LOT IN TWO DISTINCT PHASES. EACH PHASE WILL UTILIZE THE OTHER AS A LAYDOWN / STORAGE AREA.

GENERAL CONTRACTOR WILL BE RESPONSIBLE FOR SUBMITTING PHASING PLAN TO VA COR FOR APPROVAL AND WILL BE REQUIRED TO USE INTERNAL AREAS FOR LAYDOWN AND STORAGE.

ONCE CONSTRUCTION IS COMPLETE, PRESSURE WASH PAVEMENT TO PURGE BLACK ASPHALT WITH NO DIRT AND DEBRIS - SUBJECT TO APPROVAL FROM VA COR.

MOBILIZATION:

EARTHWORK, CONCRETE AND PAVING CONTRACTORS SHALL MOBILIZE THREE (3) TIMES, ONCE PER PHASE.

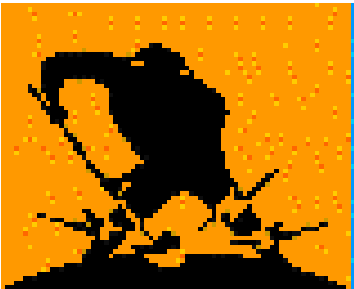


ALL LINES UTILITY SERVICES
12211 W FAIRVIEW AVE.
STOP 4
MILWAUKEE, WI 53226
(414) 302-9750

Private Lines Inc.

PRIVATE LINES INC.
E3221 STATE RD. 161
IOLA, WI 54945
(888) 246-0220

Amendment 1	04/17/14
Revisions:	Date

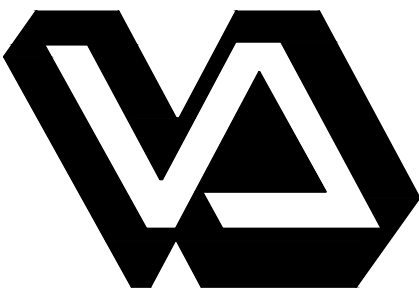

Dept. of Veterans Affairs
Medical Center
5000 W. National Avenue
Milwaukee, WI



CONSULTANTS:



Dianna Forster Associates
213 Nicollet Mall
Minneapolis, MN 55402
phone 612.332.7322
fax 612.332.0936
www.diaforster.com




www.thesigmagroup.com
1300 West Canal Street
Milwaukee, WI 53233
Phone: 414-643-4200
Fax: 414-643-4210

PROJECT LEADER:



ASHLAND, WI
211 5TH STREET WEST
ASHLAND, WI 54806
PHONE: (715) 682-0004
FAX: (715) 682-0003
MILWAUKEE, WI
903 N. MAYFAIR RD.
SUITE 300
MILWAUKEE, WI 53226
PHONE: (414) 258-0054
FAX: (414) 258-0154

Drawing Title Detailed Grading Plan	Project Title SITE SOUTH EAST AREA PARKING LOT	Project Number 695-13-174	Building Number -	Office of Facilities Management
Approved: Project Director	Location VA Medical Center, Milwaukee, WI	Drawing Number C203		Department of Veterans Affairs
	Date December 12, 2013	Checked By: DJC	Drawn By: NLB	

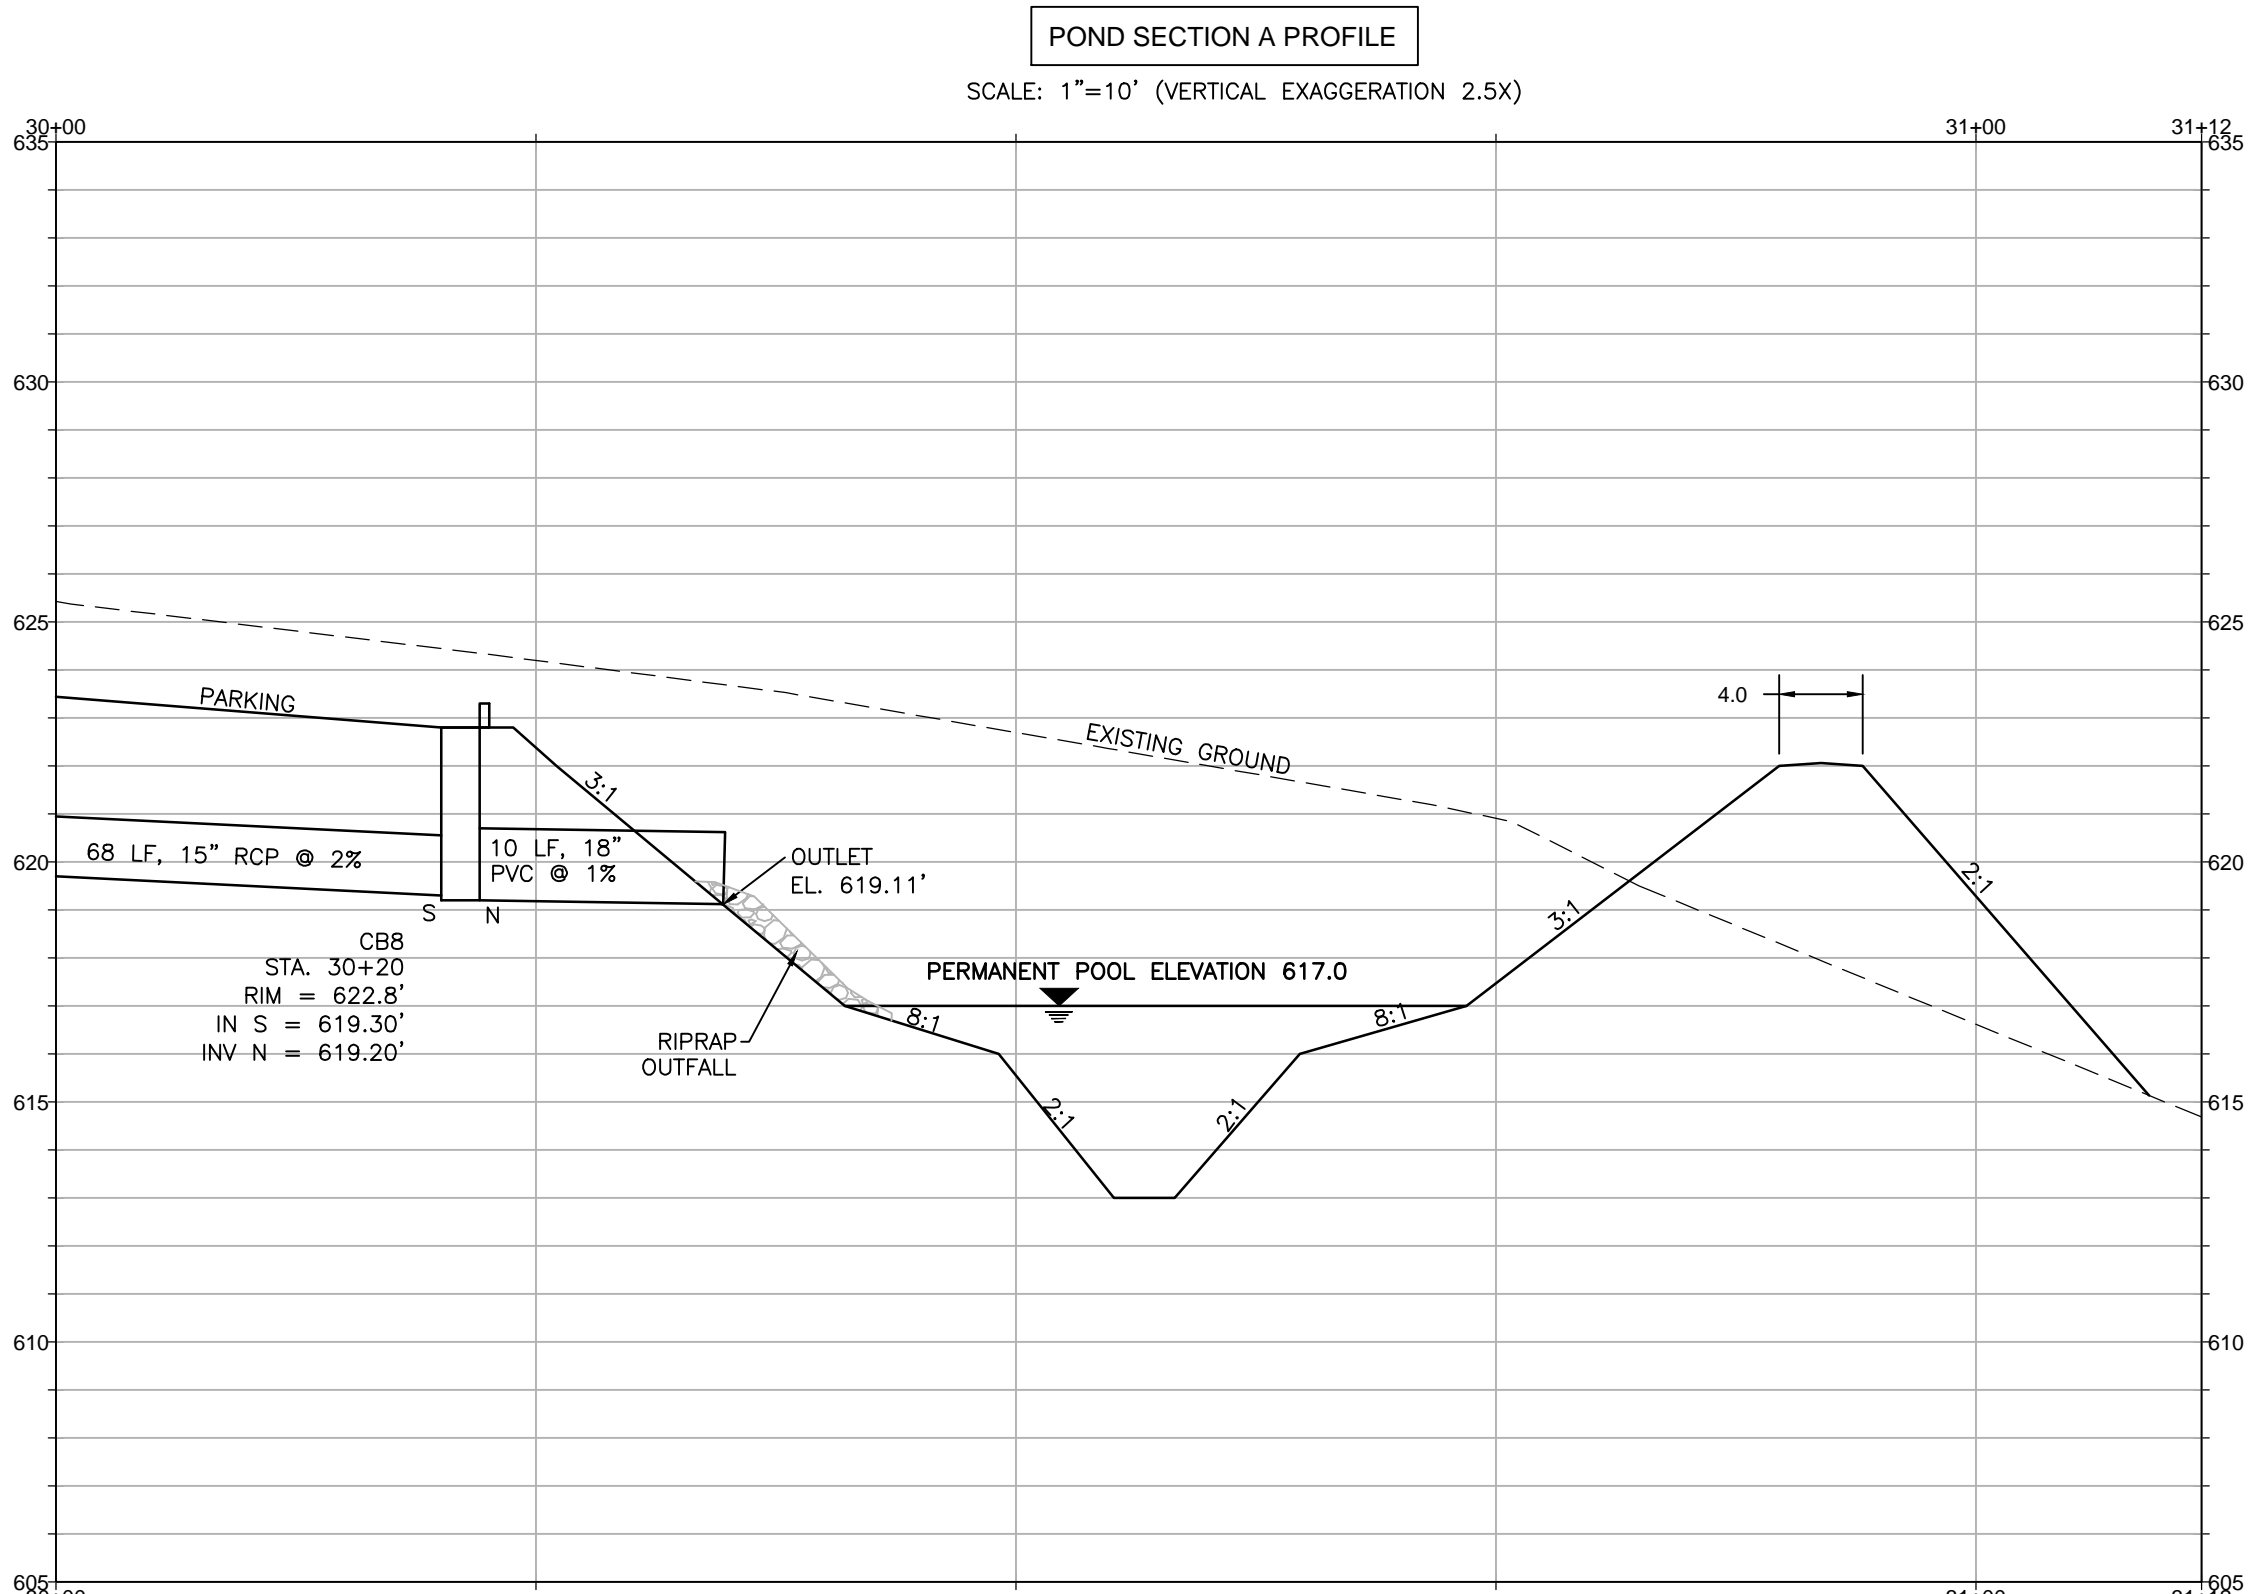





POND CONSTRUCTION NOTES:

NATIVE SILTY CLAY SOIL SHALL ACT AS LINER.
(MINOR TECH STANDARD 1001)

CONTRACTOR TO OVER EXCAVATE THE BASE OF THE POND UP TO THE 2 YEAR WATER LEVEL SHOWN BELOW (618.55'). CONTRACTOR WILL THEN IMPORT NATIVE SILTY/CLAY MATERIAL FROM THE SITE AND INSTALL NATIVE SOIL LINER.


NATIVE LINER TO BE INSTALLED PER NATURAL RESOURCE CONSERVATION SERVICE, WISCONSIN CONSTRUCTION SPECIFICATION 204, EARTH FILL FOR WASTE STORAGE FACILITIES.

GENERAL NOTE:
PROVIDE POST-CONSTRUCTION WI-R.L.S. STAMPED AS-BUILT DRAWING.

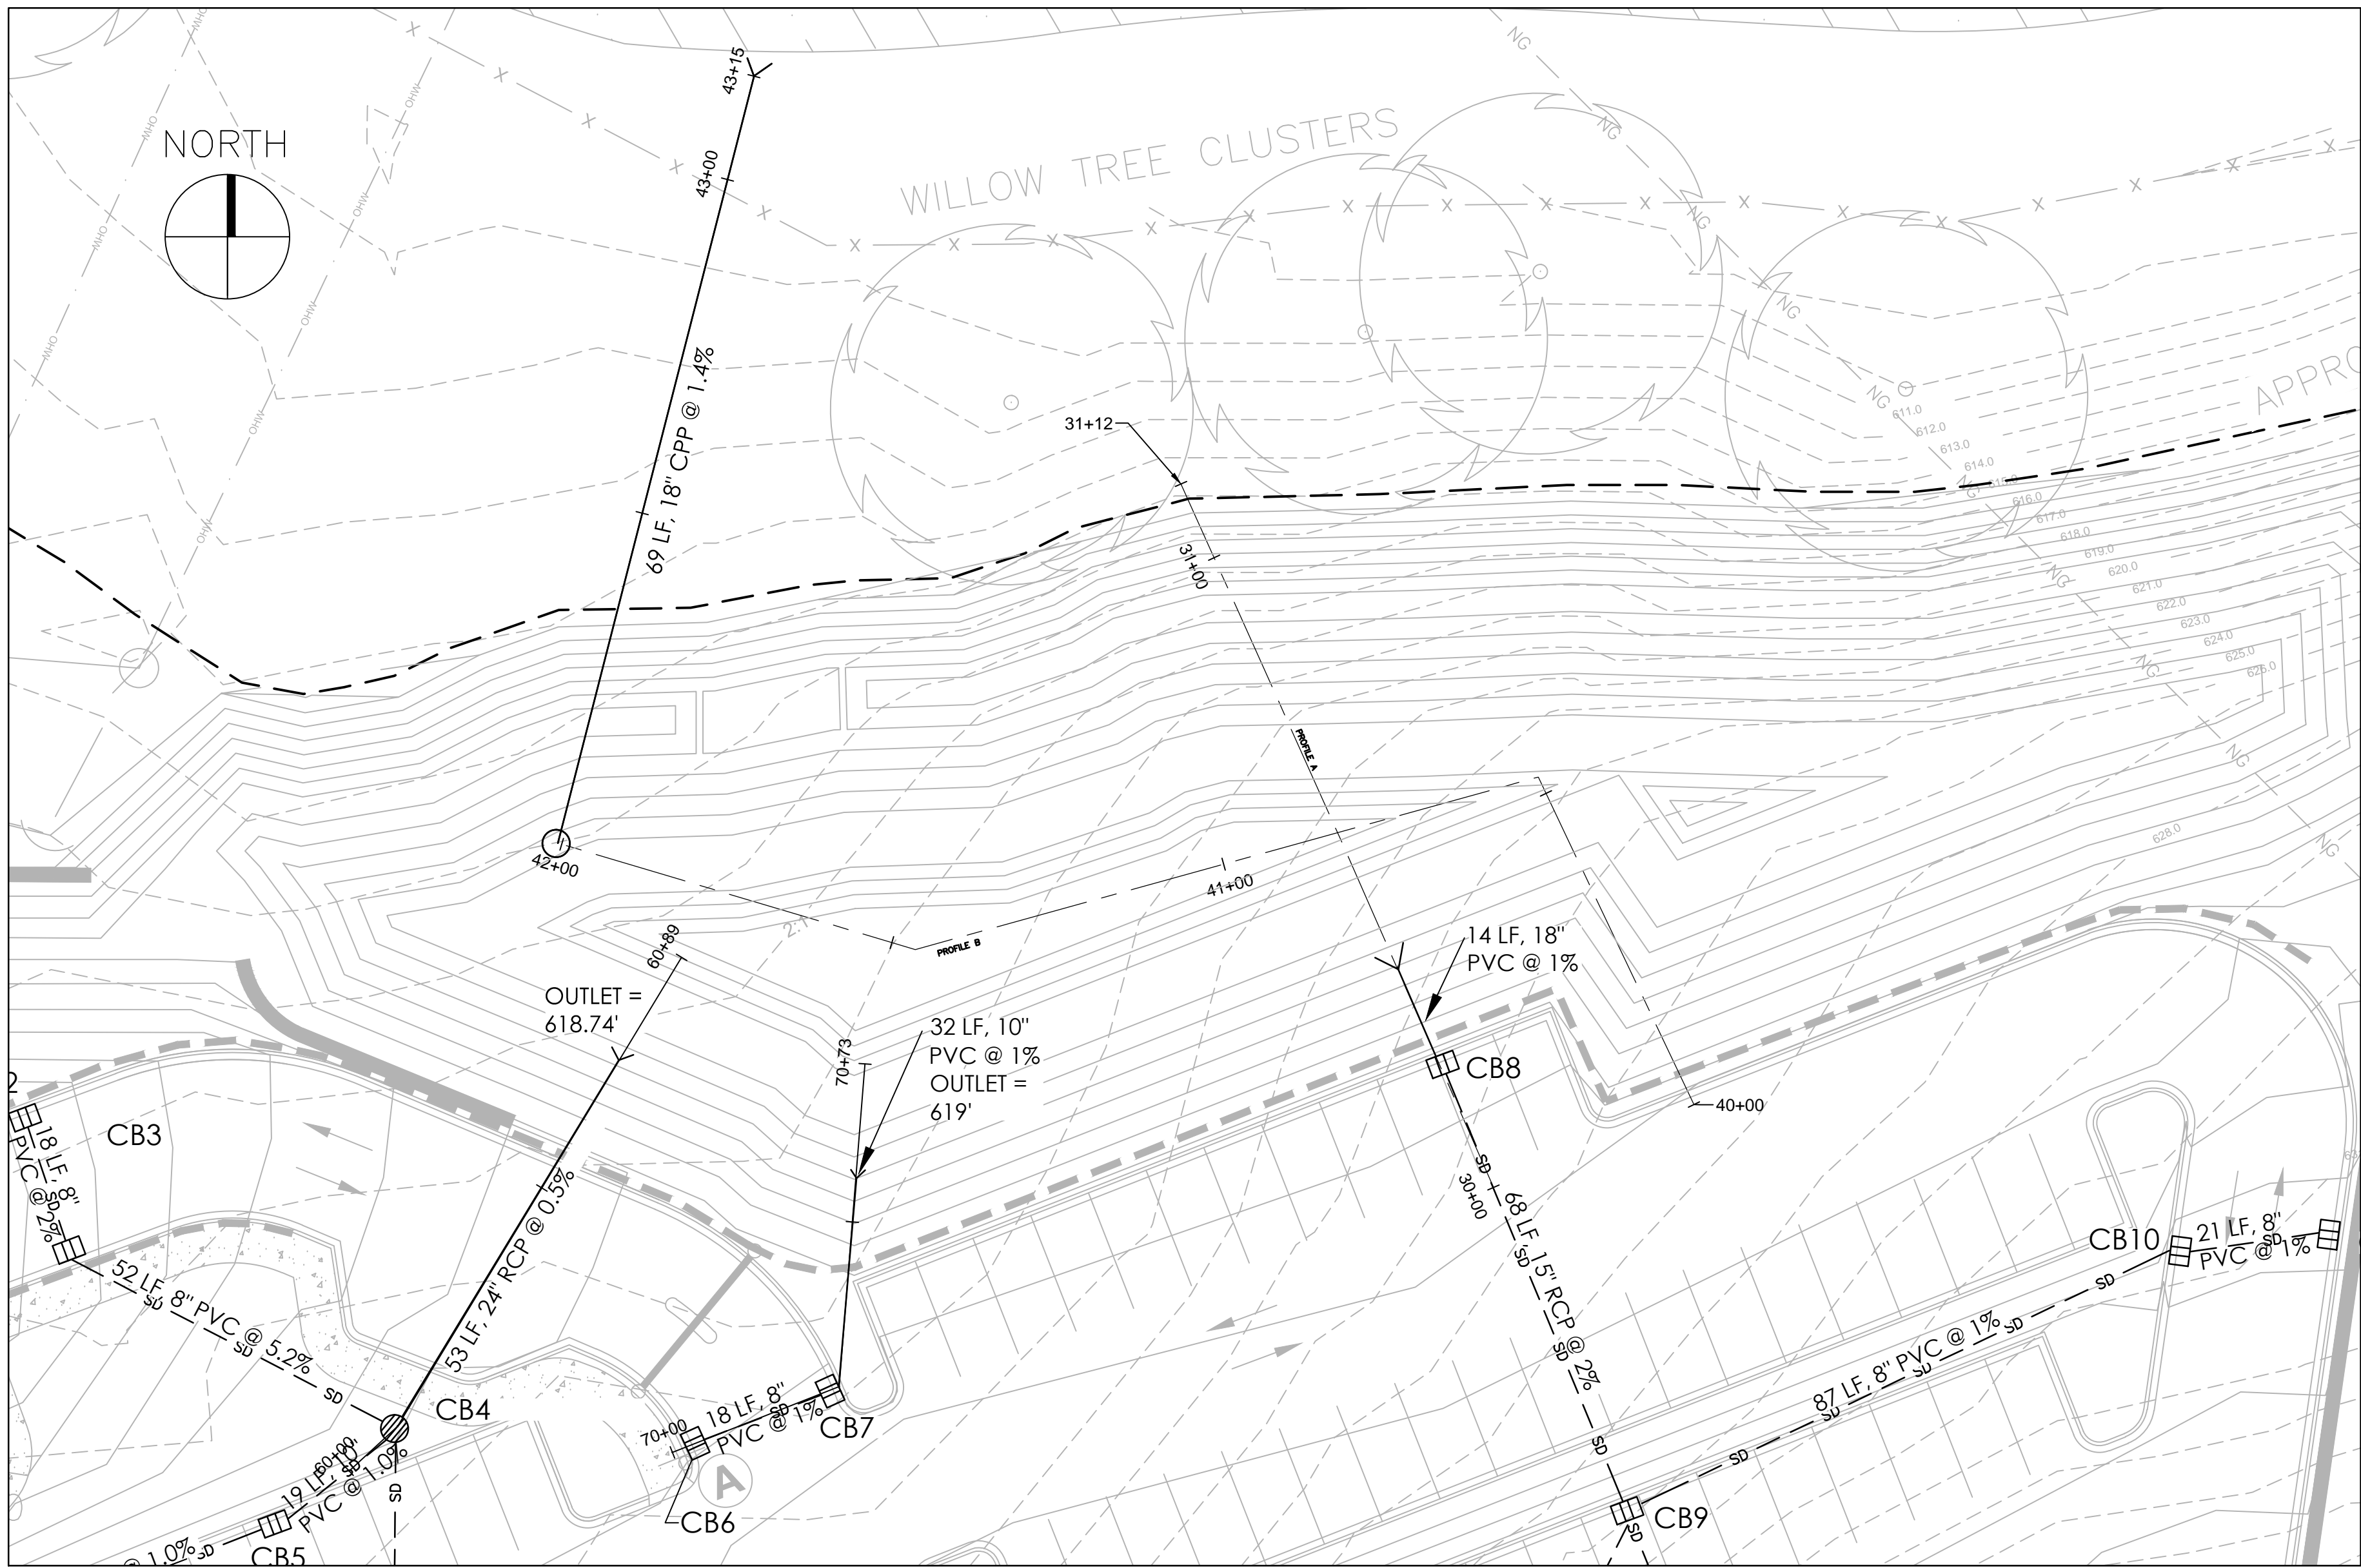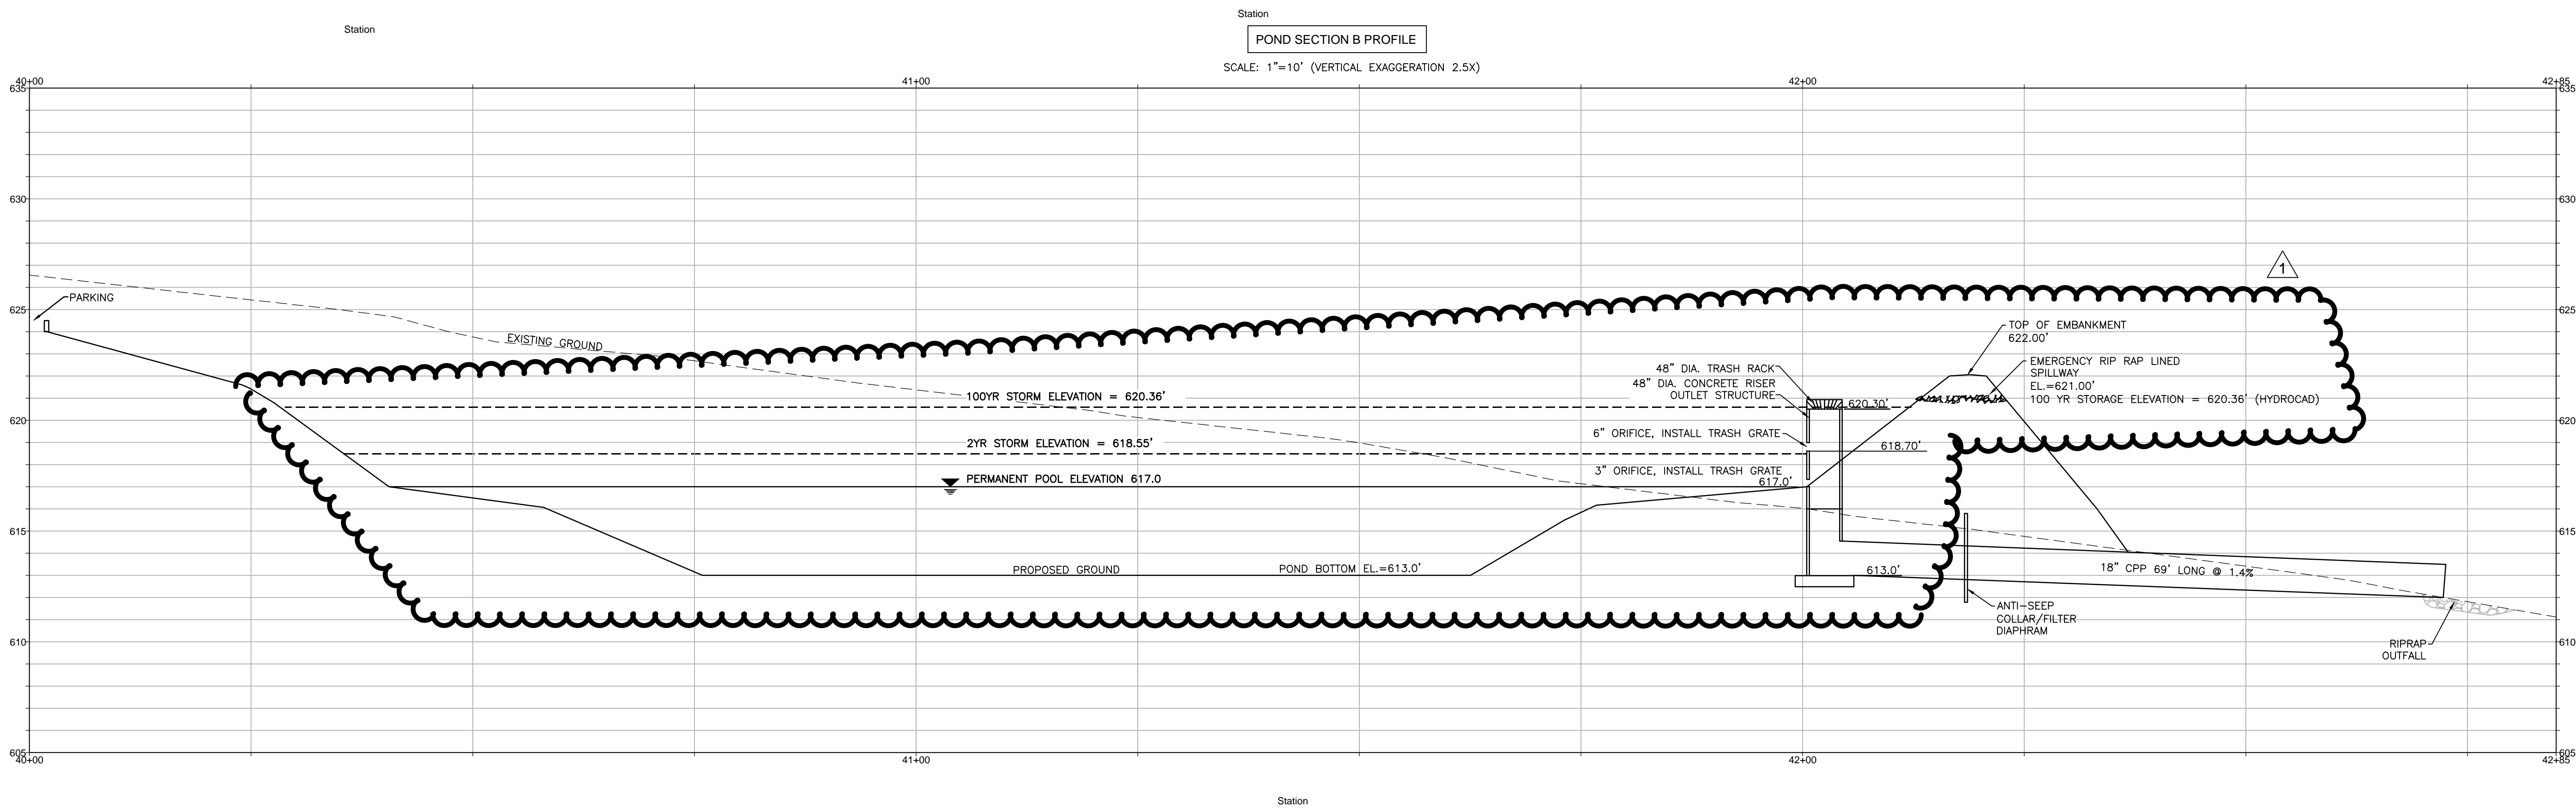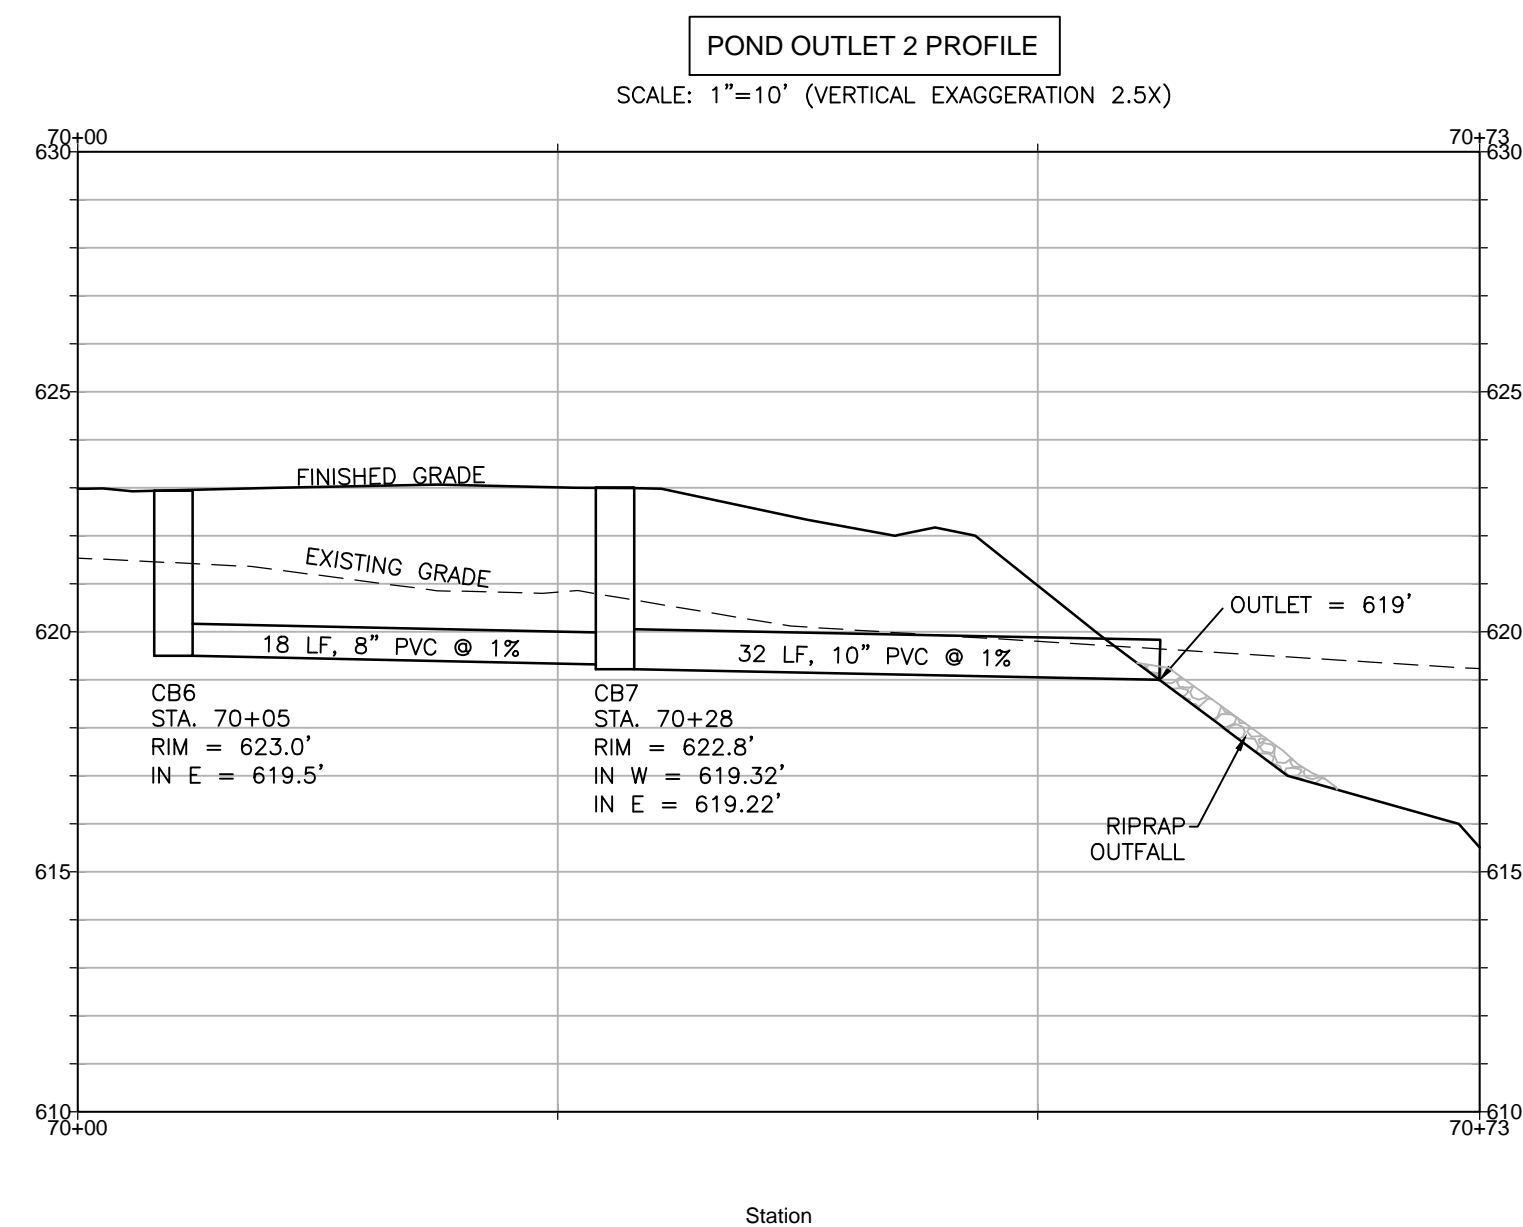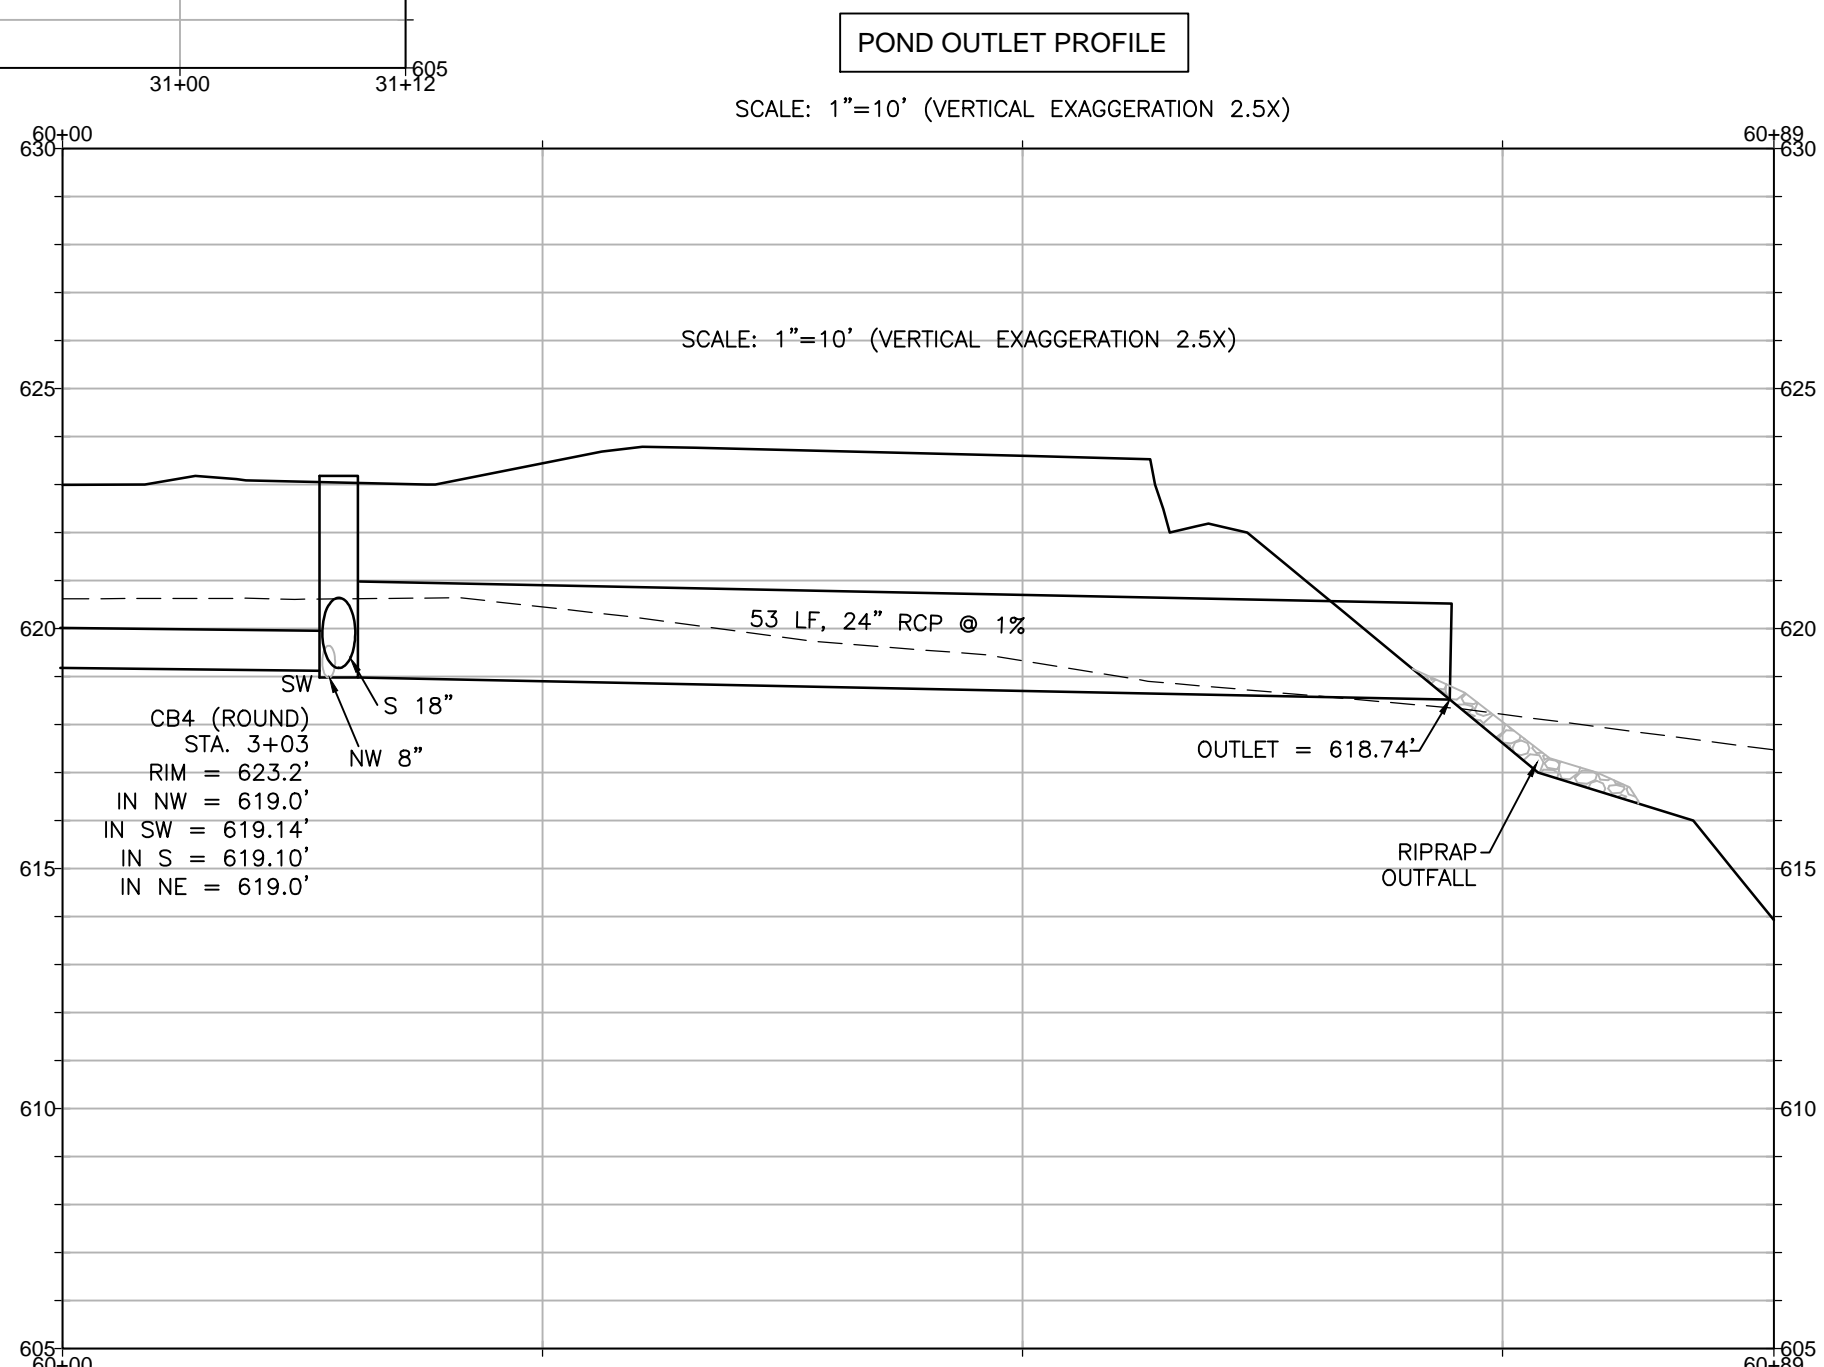


PROFILE KEY
NOT TO SCALE

NOTE:
PROVIDE POST-CONSTRUCTION
WI-R.L.S. STAMPED AS-BUILT
DRAWING.

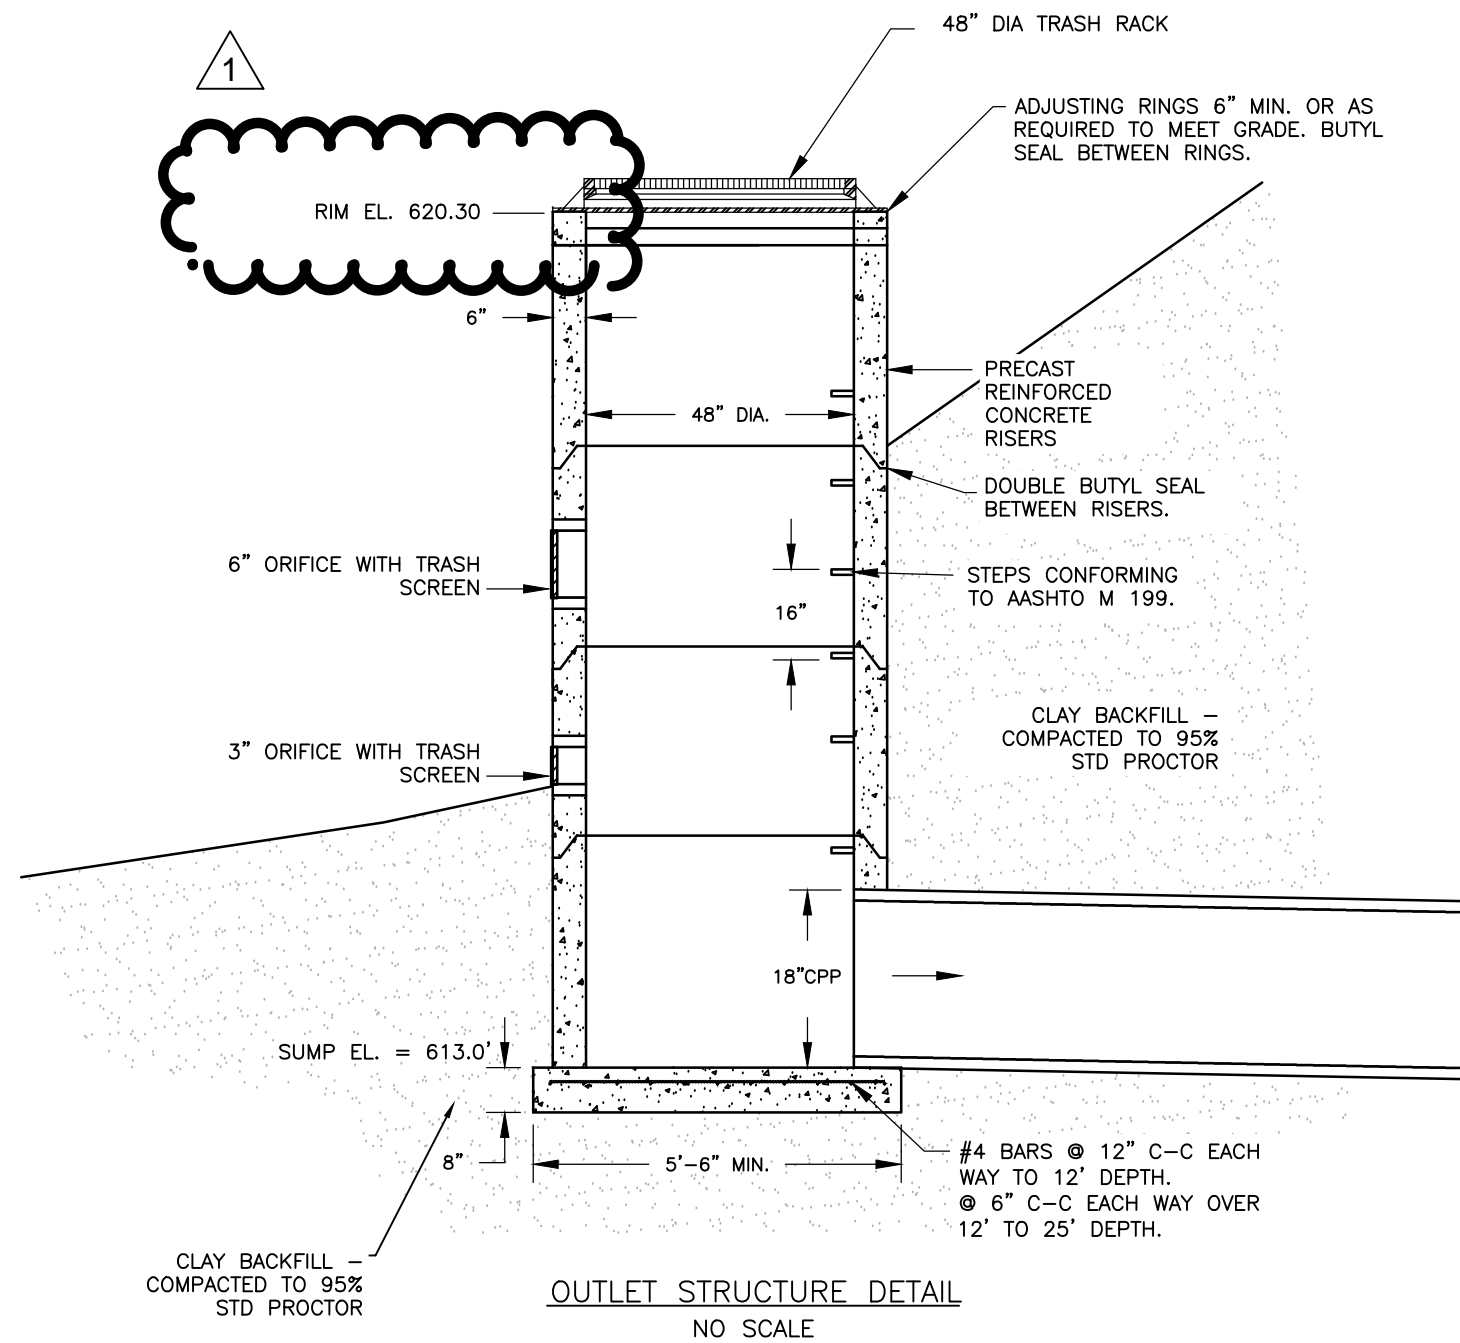

Per City comments, changed notations on liner materials and elevations for pond profile and outlet structure.	04/17/14 Date
Amendment 1	
Revisions:	

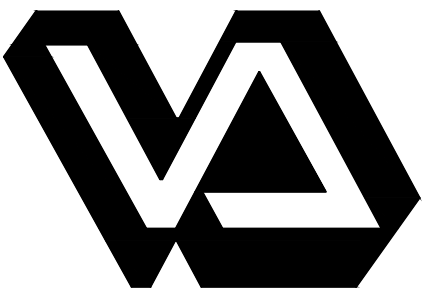

Dept. of Veterans Affairs
Medical Center
5000 W. National Avenue
Milwaukee, WI



CONSULTANTS:




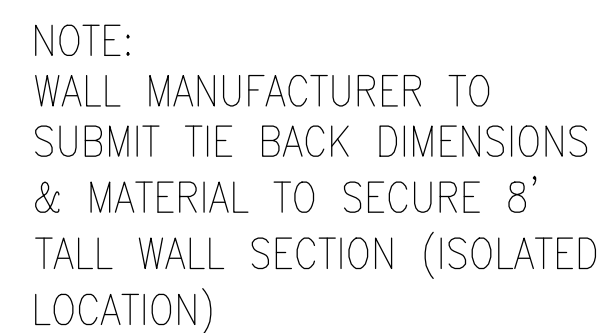
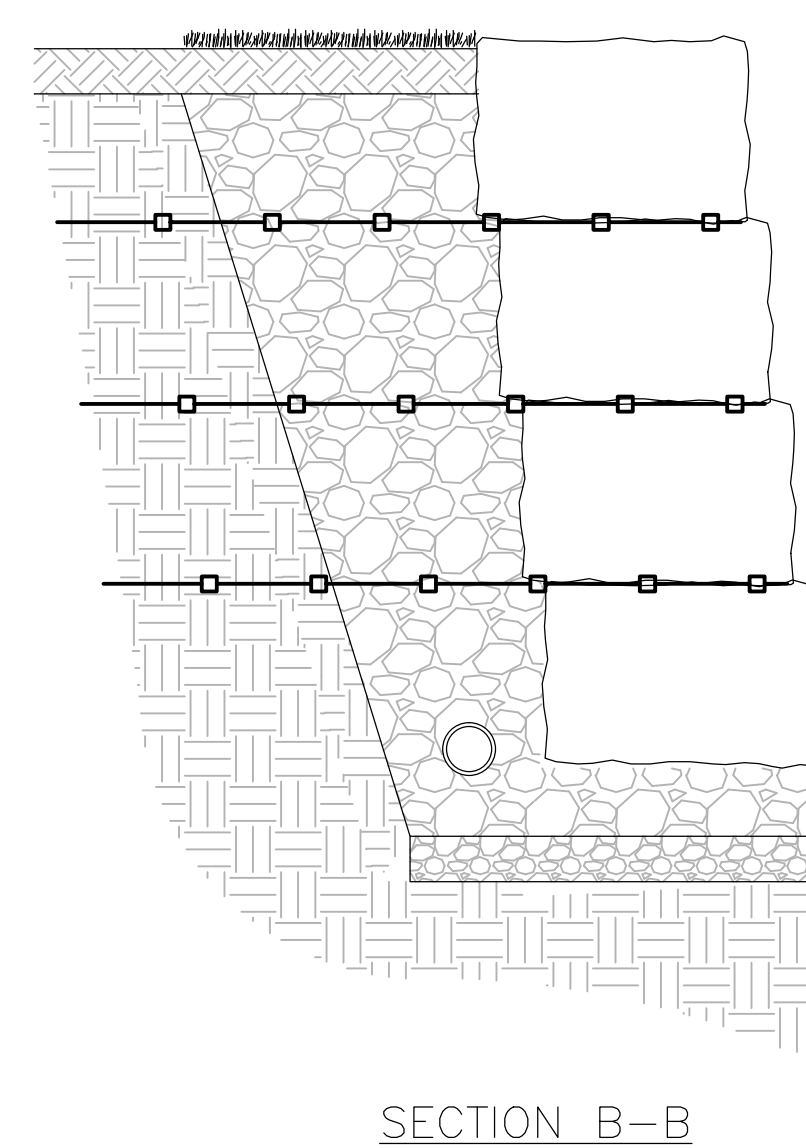
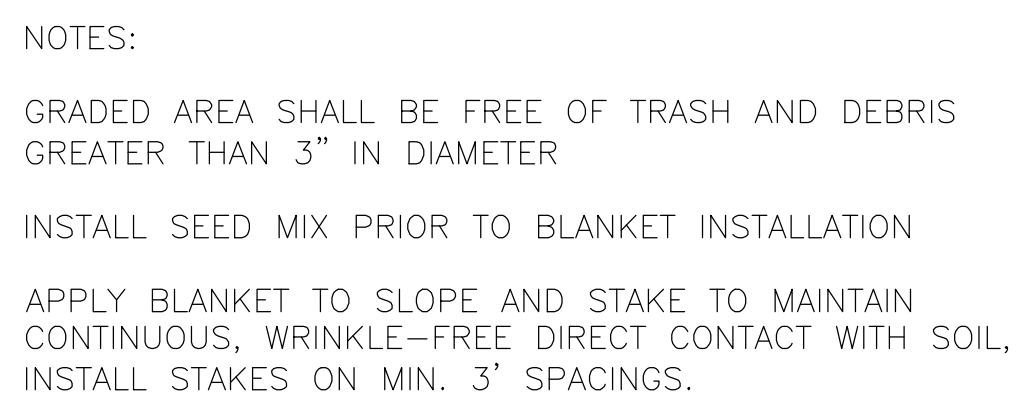
THE SIGMA GROUP
Single Source. Sound Solutions.
www.thesigmagroup.com
1300 West Canal Street
Milwaukee, WI 53233
Phone: 414-643-4200
Fax: 414-643-4210

PROJECT LEADER:



ASHLAND, WI
211 5TH STREET WEST
PO BOX 100
PHONE: (715) 682-0004
FAX: (715) 682-0003
MILWAUKEE, WI
803 N. MAYFAIR RD.
SUITE 300
MILWAUKEE, WI 53208
PHONE: (414) 258-0054
FAX: (414) 258-0154

Drawing Title Stormwater Pond Profiles	Project Title SITE SOUTH EAST AREA PARKING LOT	Project Number 695-13-174	100% CONSTRUCTION DOCUMENTS	
Approved: Project Director	Location VA Medical Center, Milwaukee, WI	Building Number -	Drawing Number C209	Office of Facilities Management
Date December 12, 2013	Checked By: DJC/MAB	Drawn By: NLB	Department of Veterans Affairs	



Dept. of Veterans Affairs
Medical Center
5000 W. National Avenue
Milwaukee, WI



Dan Farber Associates
 515 Nicole Mall
 Minneapolis, MN 55405
 Tel: 612.332.7222
 Fax: 612.332.0919
danonfarber.com

THE

SIGMA
Singole Source. Sound Solutions. **GROUP**

www.thesigmagroup.com
 1300 West Canal Street
 Milwaukee, WI 53233
 Phone: 414-643-4200
 Fax: 414-643-4210

RIX GROUP
 A COMMERCIAL REAL ESTATE GROUP

PROJECT LEADER:



ASHLAND, WI

211 6TH STREET WEST
ASHLAND, WI 54806
PHONE: (715) 682-8004
FAX: (715) 682-8035

MILWAUKEE, WI

823 N. MAYFAIR RD.,
SUITE 100
MILWAUKEE, WI 53226
PHONE: (414) 358-0584
FAX: (414) 358-0514






Project Title		
SITE SOUTH EAST AREA PARKING LOT		
Location		
VA Medical Center, Milwaukee, WI		
Date	Checked By:	Drawn By:
December 12, 2013	DJC/MAB	NLB

Project Number	695-13-174
Building Number	-
Drawing Number	C301

Office of
Facilities
Management



1 2 3 4 5 6 7 8 9

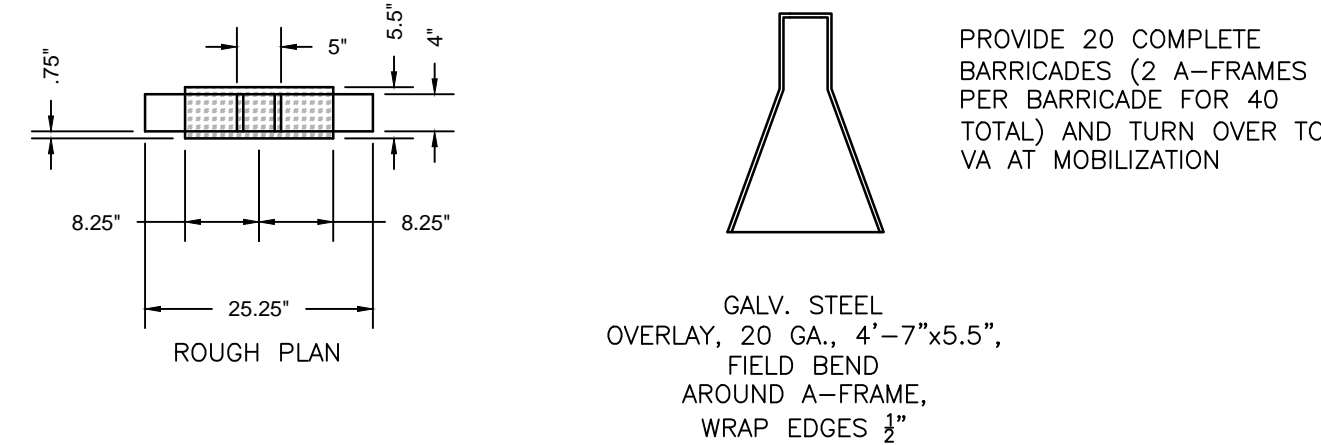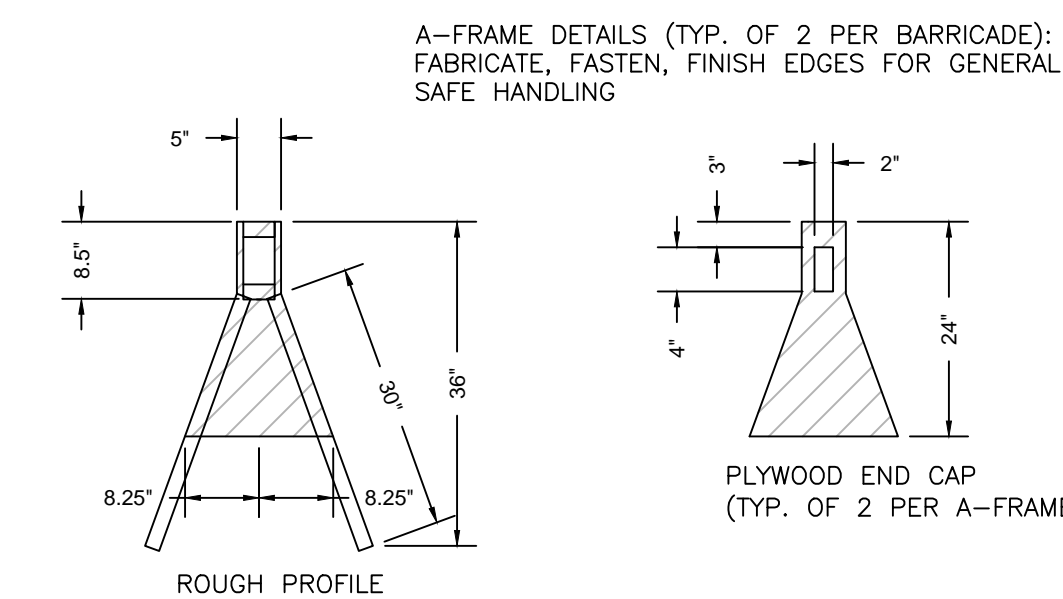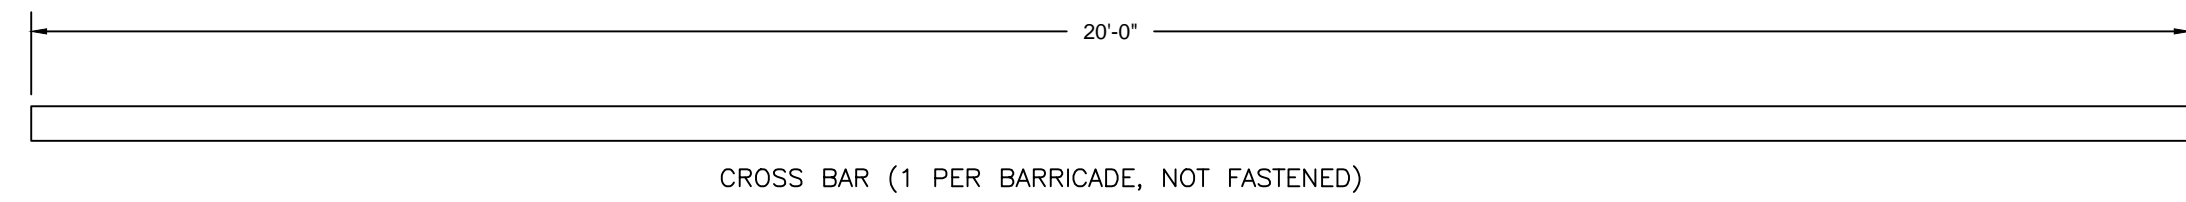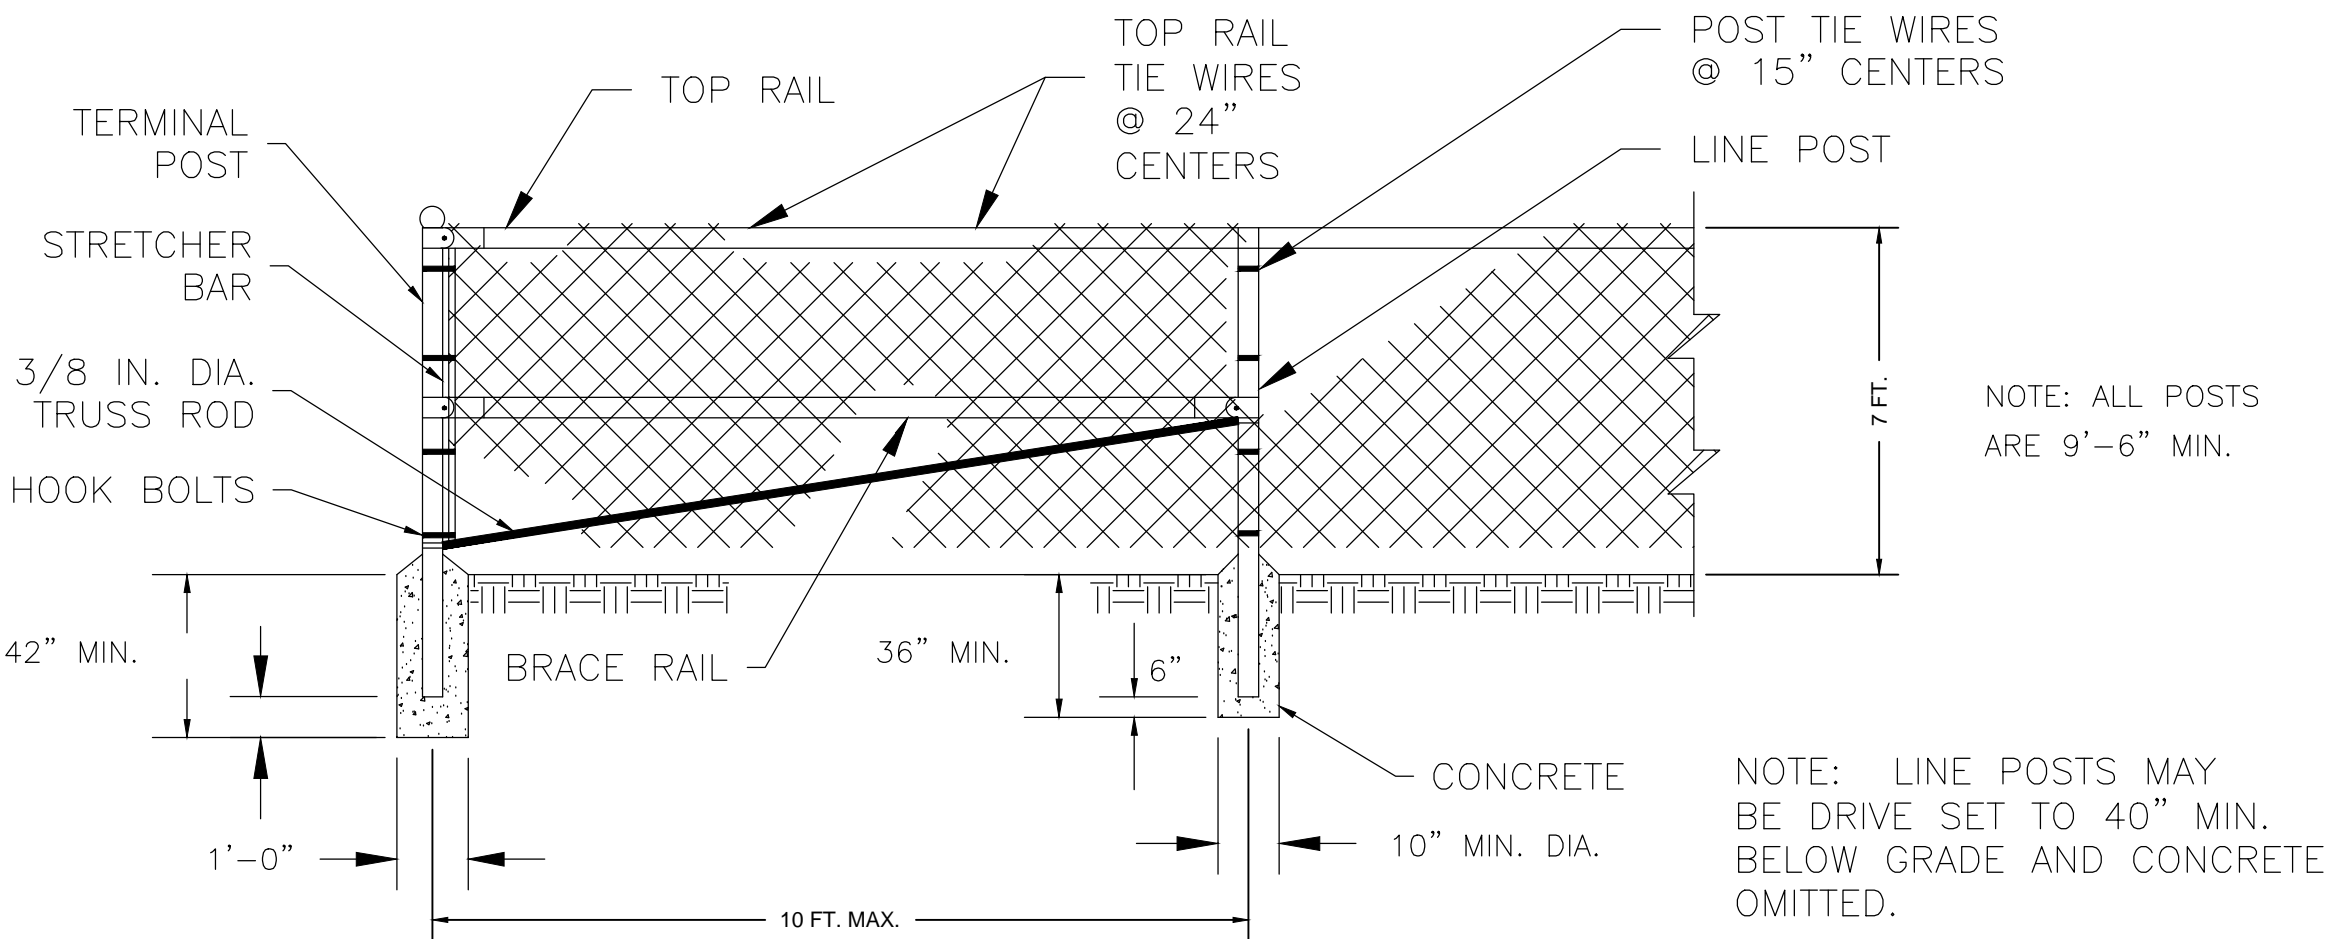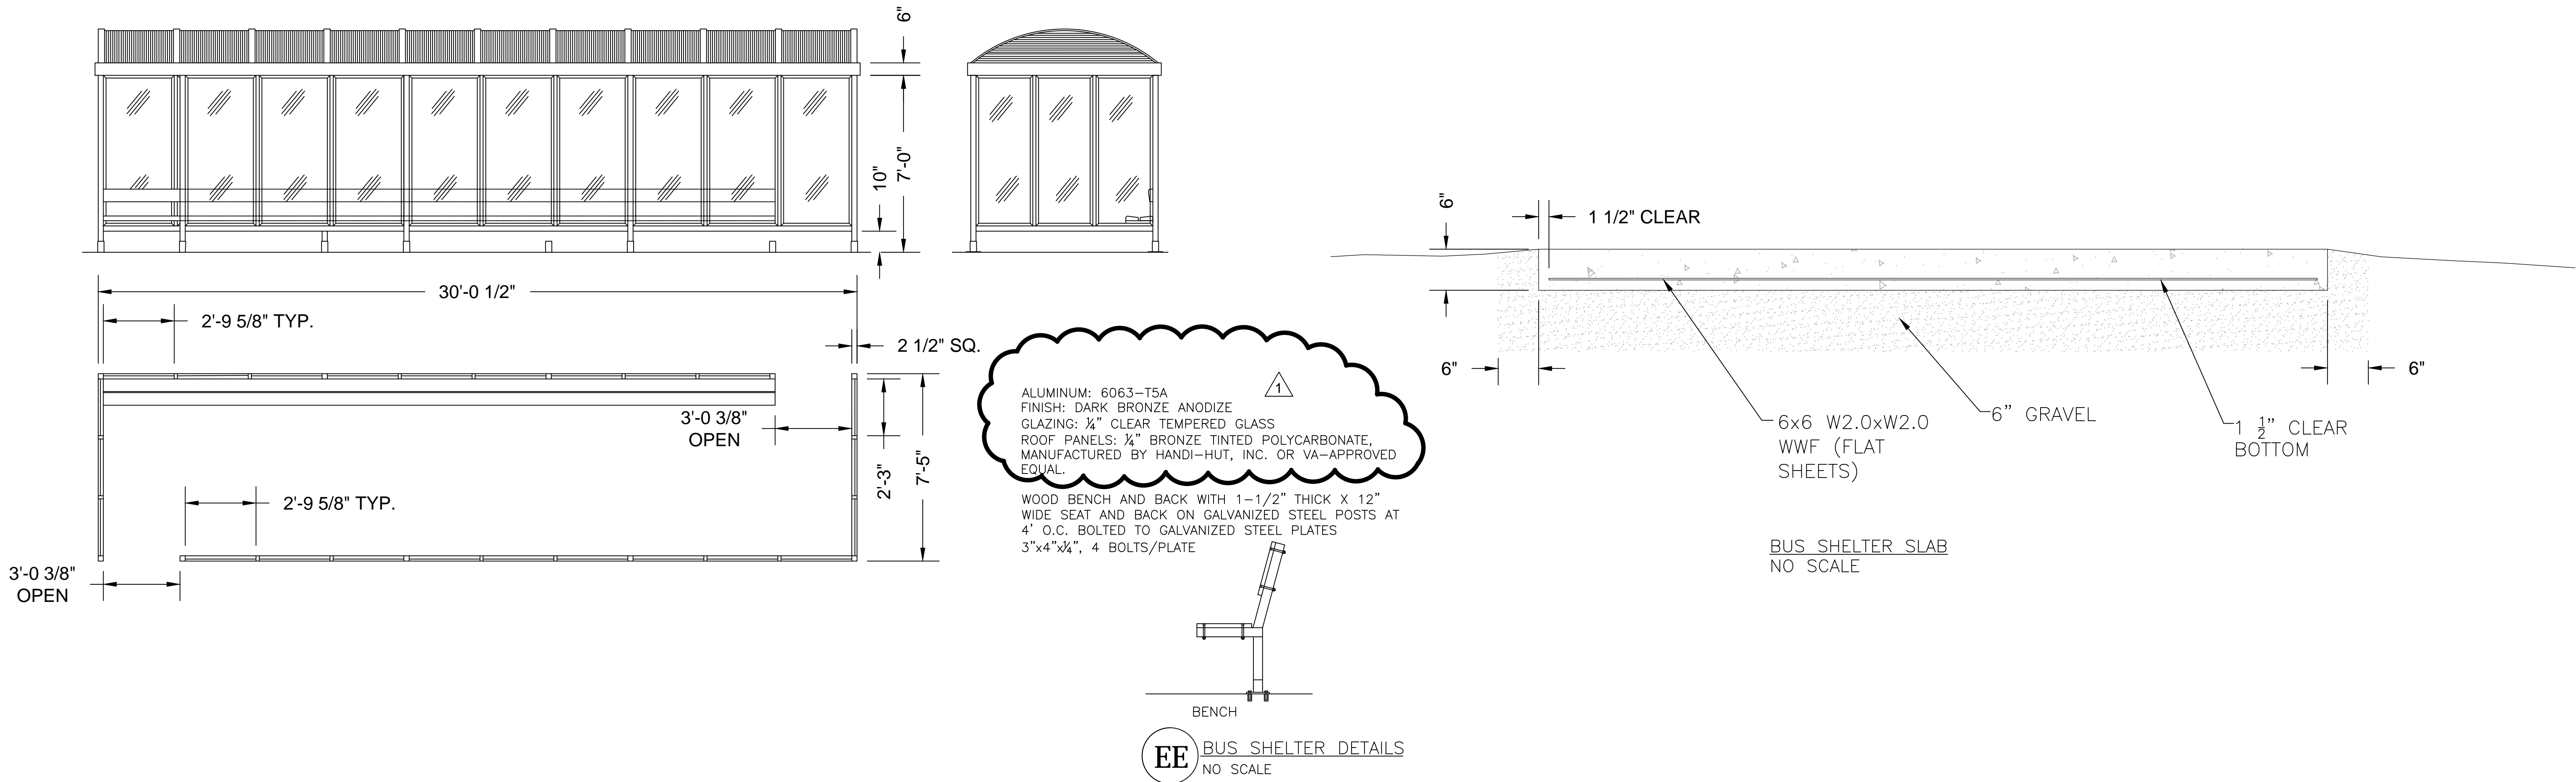

- NOTES:
1. LUMBER SHALL BE NEW SYP #1 NOM. 2"x4", PT WITH MCA
1A. PLYWOOD: 3/4" PRESSURE TREATED CDX.
 2. SUPPLIER: BLUFFERT LUMBER OR VA APPROVED EQUAL.
 3. FASTENERS: NEW GALVANIZED OR ZINC-COATED #10 FLAT HEAD WOOD SCREWS.
 4. MITRES NOT SHOWN. CARPENTER TO FIELD FABRICATE MITRES TO 1/4" FLUSH TOLERANCE.
 5. PRIME WITH OIL-BASED OPAQUE STAIN, TWO COATS

GG BARRICADE ASSEMBLIES
NO SCALE

100% CONSTRUCTION DOCUMENTS									
Amendment 1 		04/17/14		Date		Revisions:			
		Dept. of Veterans Affairs Medical Center 5000 W. National Avenue Milwaukee, WI				CONSULTANTS:		PROJECT LEADER:	
		Damon Farber Associates 923 Nicollet Mall Minneapolis, MN 55402 phone 612.332.7322 fax 612.332.0936 www.damonfarber.com						ASHLAND, WI 211 6TH STREET WEST ASHLAND, WI 54805 PHONE: (715) 682-0004 FAX: (715) 682-0003 MILWAUKEE, WI 903 N. MAYFAIR RD. SUITE 300 MILWAUKEE, WI 53208 PHONE: (414) 258-0054 FAX: (414) 258-0154	
Drawing Title		DETAILS		Project Title		SITE SOUTH EAST AREA PARKING LOT		Project Number 695-13-174	
Approved: Project Director		Location		VA Medical Center, Milwaukee, WI		Building Number		Office of Facilities Management	
Date December 12, 2013		Checked By: DJC/MAB		Drawn By: NLB		Drawing Number		C304	
									

1 2 3 4 5 6 7 8 9